


NEW PINE CREEK CEMETERY

FINAL PROOF SURVEY AND CLAIM OF BENEFICIAL USE
 LOCATED IN THE NW 1/4 OF SECTION 19 TOWNSHIP 41 SOUTH RANGE 21 EAST
 LAKE COUNTY, OREGON

NOTE: PREPARATION OF THIS MAP IS FOR IDENTIFYING PROPOSED WATER RIGHTS ONLY. IT HAS NO INTENT TO PROVIDE LOCATIONS OR DIMENSIONS OF PROPERTY BOUNDARIES.

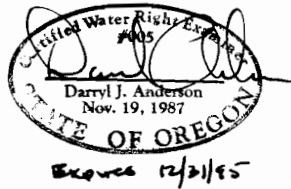

APPLICATION NO. 12358


PERMIT NO. 11297

RECEIVED

SCALE: 1"=400'

LEGEND

o 3/4" FAUCET (HOSE BIB) FOR WATER USE AND IRRIGATION

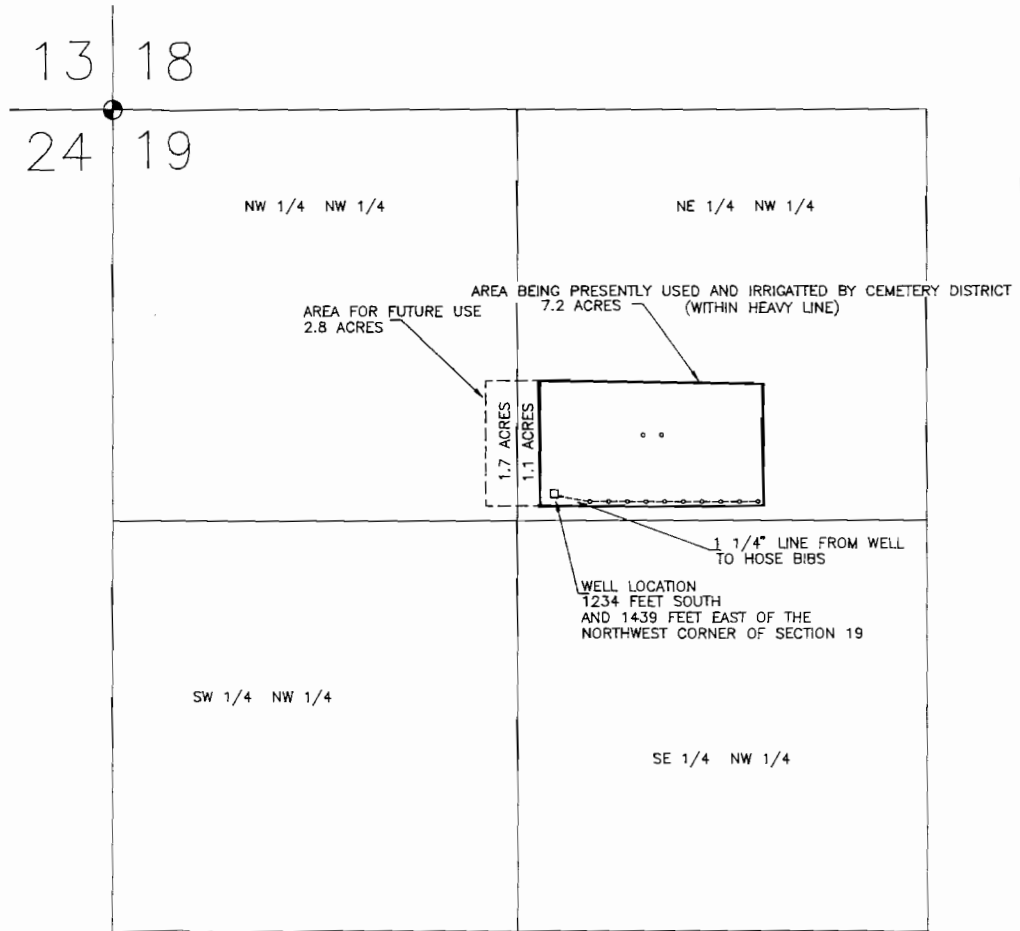

REVISION BY

ANDERSON ENGINEERING & SURVEYING
 P.O. BOX 419
 REDMOND, OREGON 97756
 LAKEVIEW, OREGON 97630
 (503) 923-4307
 (503) 947-4407
 FAX 923-4308
 FAX 947-2321

CLAIM OF BENEFICIAL USE
 LAKE COUNTY CEMETERY DISTRICT
 928 MILLVIEW
 LAKEVIEW, OREGON 97630

DATE: SEPT. 1995

SCALE: SHOWN

JOB: 95-069

DWC. BY: DJA

FILE: 95069

SHEET 1 OF 1