

T24S, R6W, WM

SCALE 1" = 660'


DOUGLAS COUNTY

RECEIVED

OCT 21 1998

WATER RESOURCES DEPT.
SALEM, OREGON

DAVID S OR JUDITH LYNNE JOHNSON
274 FEATHER LANE
OAKLAND, OR 97462

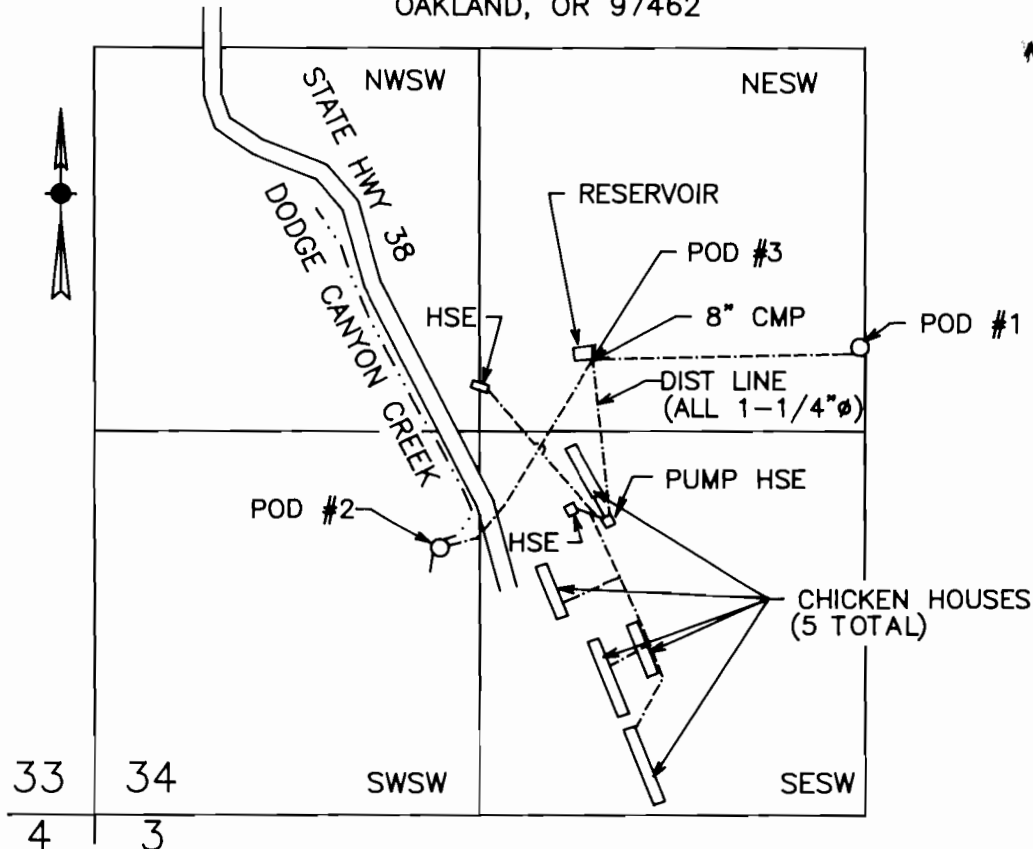

POD 1 IS 1035 FT S AND 10 FT W FROM CENTER 1/4 COR SEC 34
POD 2 IS 1720 FT S AND 1455 FT W FROM CENTER 1/4 COR SEC 34
POD 3 IS 1080 FT S AND 1005 FT W FROM CENTER 1/4 COR SEC 34


FINAL PROOF SURVEY UNDER

Application No. S-81600 Permit No. 53401
Application No. R-74154 Permit No. R-12468

IN NAME OF

DAVID S JOHNSON OR JUDITH LYNNE JOHNSON

Surveyed July 31, 1998 by M E Farr

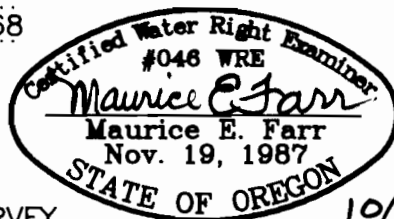

THIS IS A LOCATION MAP FOR A FINAL PROOF SURVEY
BY DAVID S OR JUDITH LYNNE JOHNSON. THIS MAP
IS FOR THE PURPOSE OF IDENTIFYING THE LOCATION
OF THE WATER RIGHT ONLY AND IS NOT INTENDED
TO PROVIDE LEGAL DIMENSIONS OR LOCATIONS OF
PROPERTY OWNERSHIP LINES.

EXPIRES 12-31-99

MAURICE E FARR
395 NE KIRBY AVENUE
ROSEBURG, OR 97470

10/98