

T 19 S, R 3 W, W.M.

RECEIVED



SEP 20 1999

WATER RESOURCES DEPT.
SALEM, OREGON

THE PURPOSE OF THIS MAP IS TO IDENTIFY THE LOCATION
OF THE WATER RIGHTS. IT IS NOT INTENDED TO PROVIDE
INFORMATION RELATIVE TO THE LOCATION OF PROPERTY
OWNERSHIP BOUNDARY LINES.



SCALE: 1" = 400'

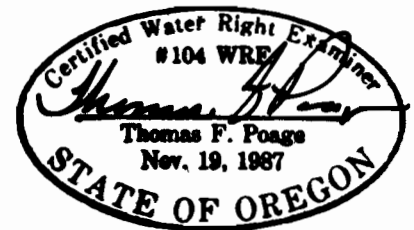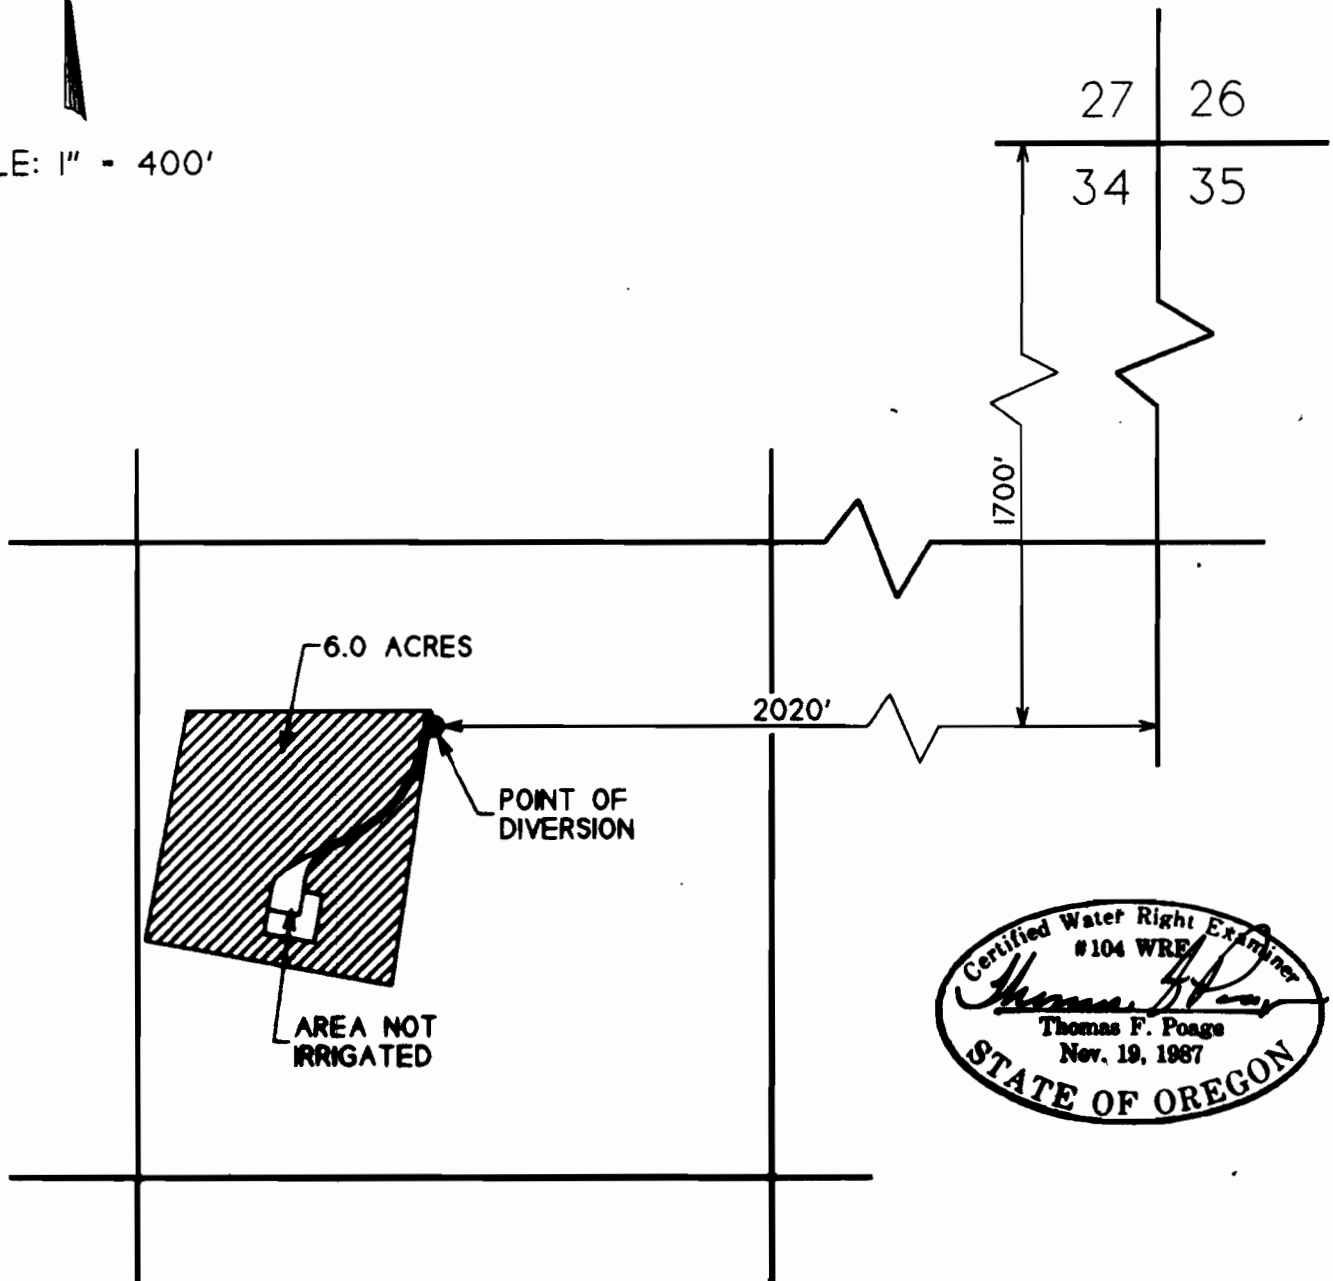

TOTAL AREA - 6.0 ACRES

FINAL PROOF SURVEY UNDER

APPLICATION NO. G-13663

PERMIT NO. G-12066

IN THE NAME OF

PAMELA J. AND ZANE L. RENFRO