


# T.8S. R.3W., W.M

Section 5

**RECEIVED**

SEP 24 1999

WATER RESOURCES DEPT.  
SALINA OFFICES

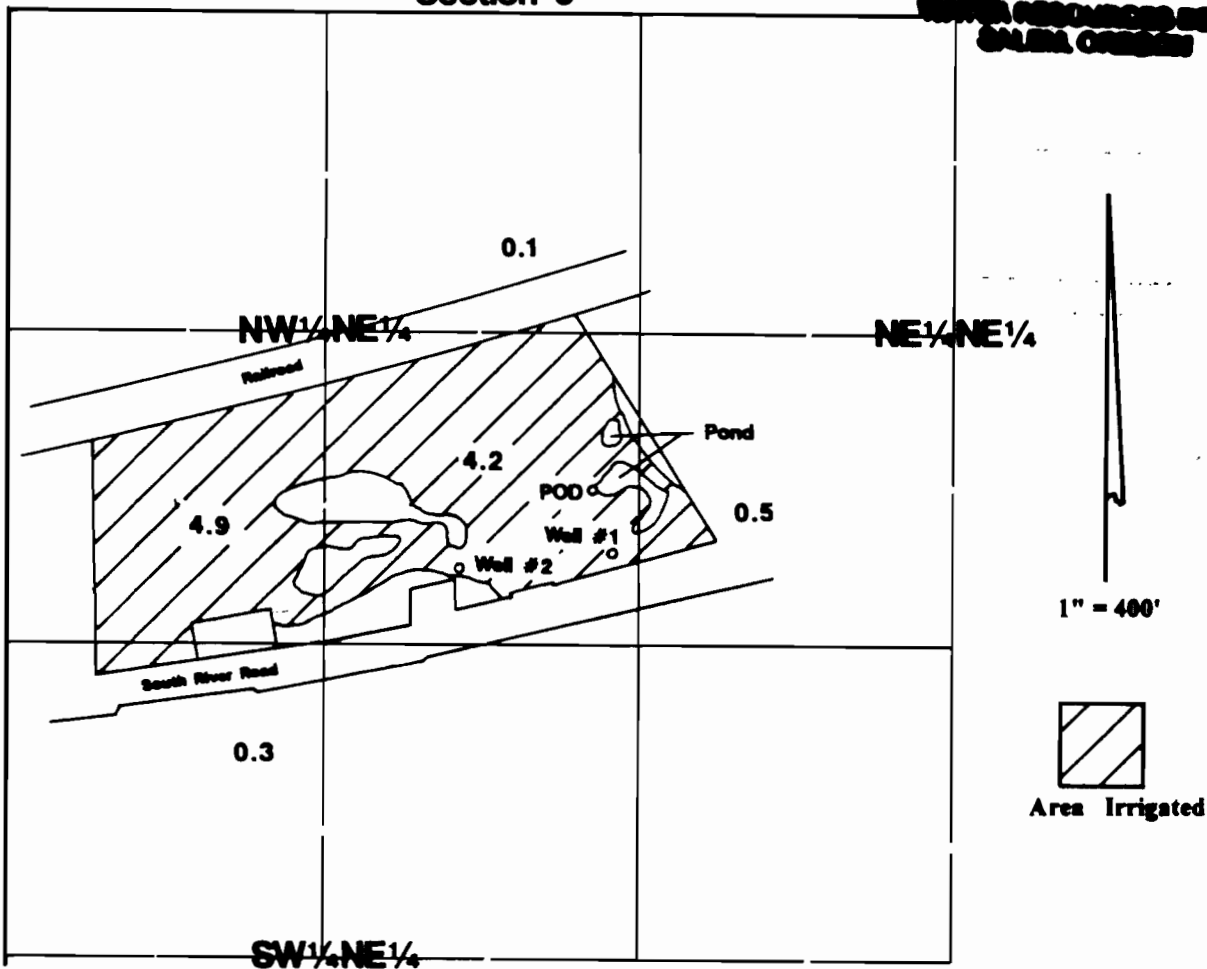

Well #1 is located 1140'S & 1260'E from the NW corner of NE1/4, Section 5.  
 Well #2 is located 1170'S & 950'E from the NW corner of NE1/4 Section 5.  
 POD is located 980'S & 1245'E from the NW corner of NE1/4 Section 5.

## Final Proof Survey

**Application #:** R-721104    **Permit #:** R-11543  
 G-12744                      G-12211

In Name Of

# Gary G. Benson

Surveyed on September 10, 1999 by JM Schuette

This Map Was Prepared For The Purpose Of Identifying The Location Of A Water Right Only And Is Not Intended To Provide Legal Dimensions Or Location Of Property Ownership Lines.

