

SECTION 3

SECTION 9

SECTION 10


PLACE OF USE
BOISE CASCADE PAPER MILL
ST. HELENS, OR
SEE EXHIBIT A SITE MAP

POINT OF DIVERSION
MULTNOMAH CHANNEL
2950 FT SOUTH 500 FT EAST
FROM NW CORNER OF SEC 10,
T4N, R1W, W.M.

**FIGURE 1
FINAL PROOF SURVEY
T4N, R1W, W.M.**

BOISE CASCADE CORPORATION PAPER MILL, ST. HELENS, OR
APPLICATION S-73831, PERMIT 51943

SCALE 1" = 1320'

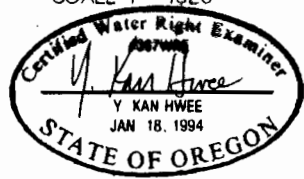

The purpose of this map is to identify the location of the water right. It is not intended to provide information relative to the location of property ownership boundary lines. This base map was prepared by the Oregon Department of Transportation in cooperation with the US Department of Transportation Federal Highway Administration.