


T. 5 N., R. 41 E., W.M.

FINAL PROOF MAP
UNDER

APPLICATION NO. R-69307 PERMIT NO. R-11656

IN NAME OF
USDA, FOREST SERVICE, UMATILLA NATIONAL FOREST
SURVEYED AUGUST 1, 2000

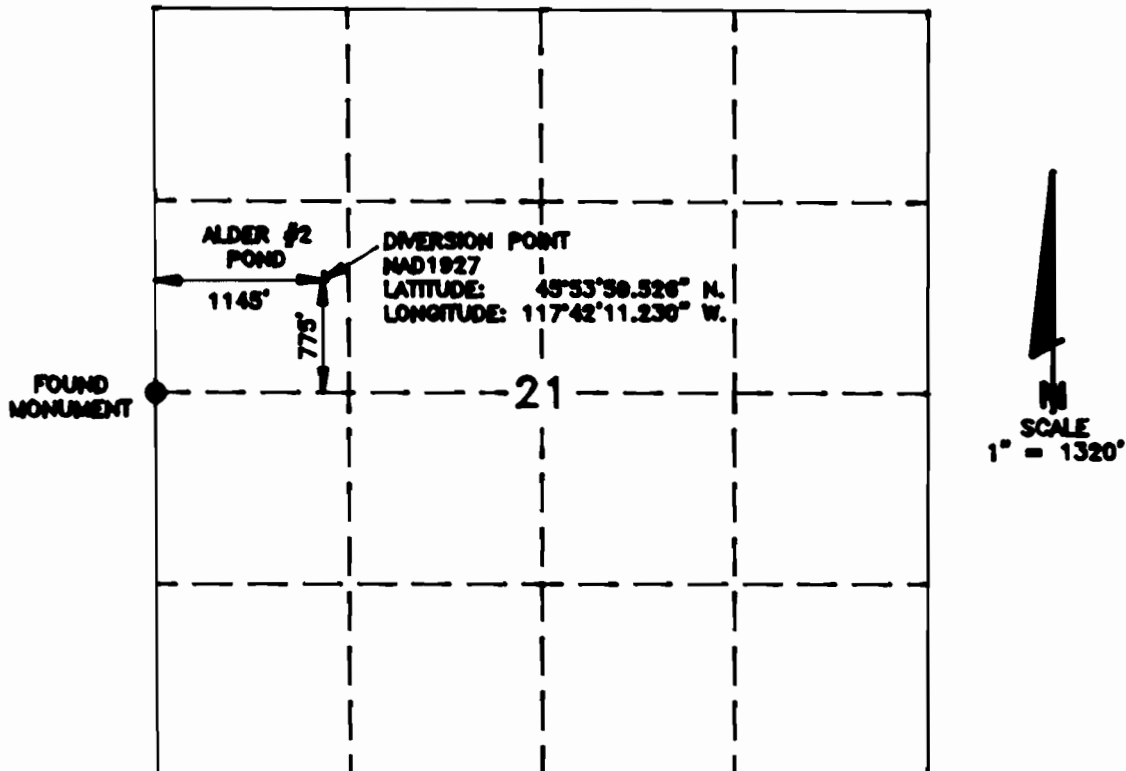

THE TIE TO THE DIVERSION POINT WAS DETERMINED BY INVERSE BETWEEN CORRECTED GPS POSITIONS WHICH WERE OBSERVED USING A TRIMBLE PATHFINDER PROXR GPS CODE RECEIVER WITH A POSITIONAL ACCURACY OF PLUS OR MINUS 2 METERS AT THE 98% CONFIDENCE LEVEL.

THE PURPOSE OF THIS MAP IS FOR IDENTIFYING THE LOCATION OF THE WATER RIGHT ONLY. IT IS NOT INTENDED TO PROVIDE LEGAL DIMENSIONS OR LOCATION OF PROPERTY OWNERSHIP LINES.

EXECUTED BY
DAVID A. SCHLAICH, CWRE 433
UMATILLA NATIONAL FOREST
2517 SW HAILEY AVENUE
PENDLETON, OR. 97801
PHONE: (541) 278-3716

RECEIVED

OCT 18 2000



RENEWAL DATE: 06/30/2002

WATER RESOURCES DEPT
SALEM, OREGON