


FINAL PROOF MAP

Under Application No. R-80961. Permit No. R-11862

Applicant: Timothy E. & Janice M. Heeter
Route 1, Box 113
Richland, OR 97870

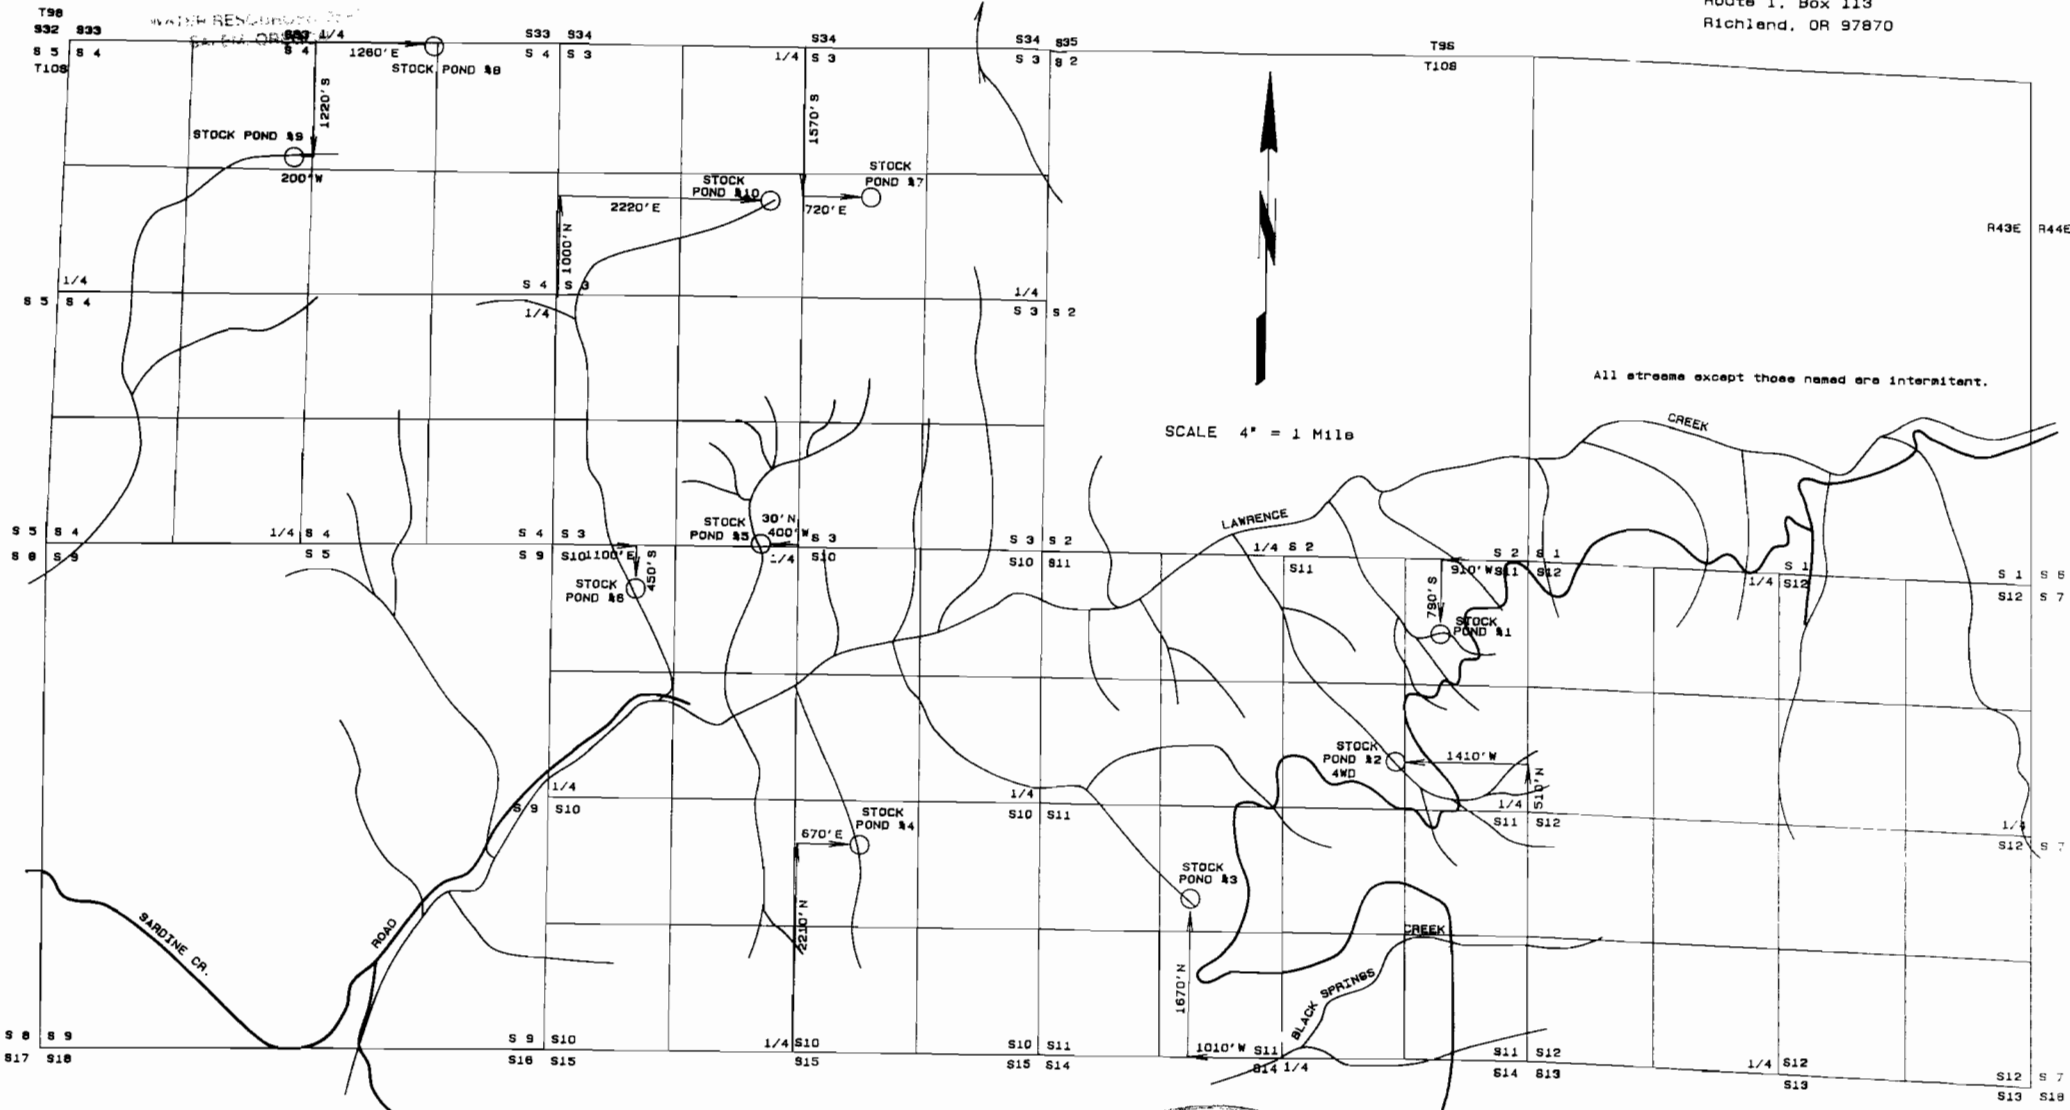

This map is for the purpose of identifying the location of the water right only and has no intent to provide dimensions or location of property ownership lines.



Surveyed November 4, 1997