


REVISED


DEC 17 1997

FINAL PROOF MAP
Under Application No. 71121, Permit No. 52999

Applicant: Timothy E. & Janice M. Heeter
Route 1, Box 113
Richland, OR 97870

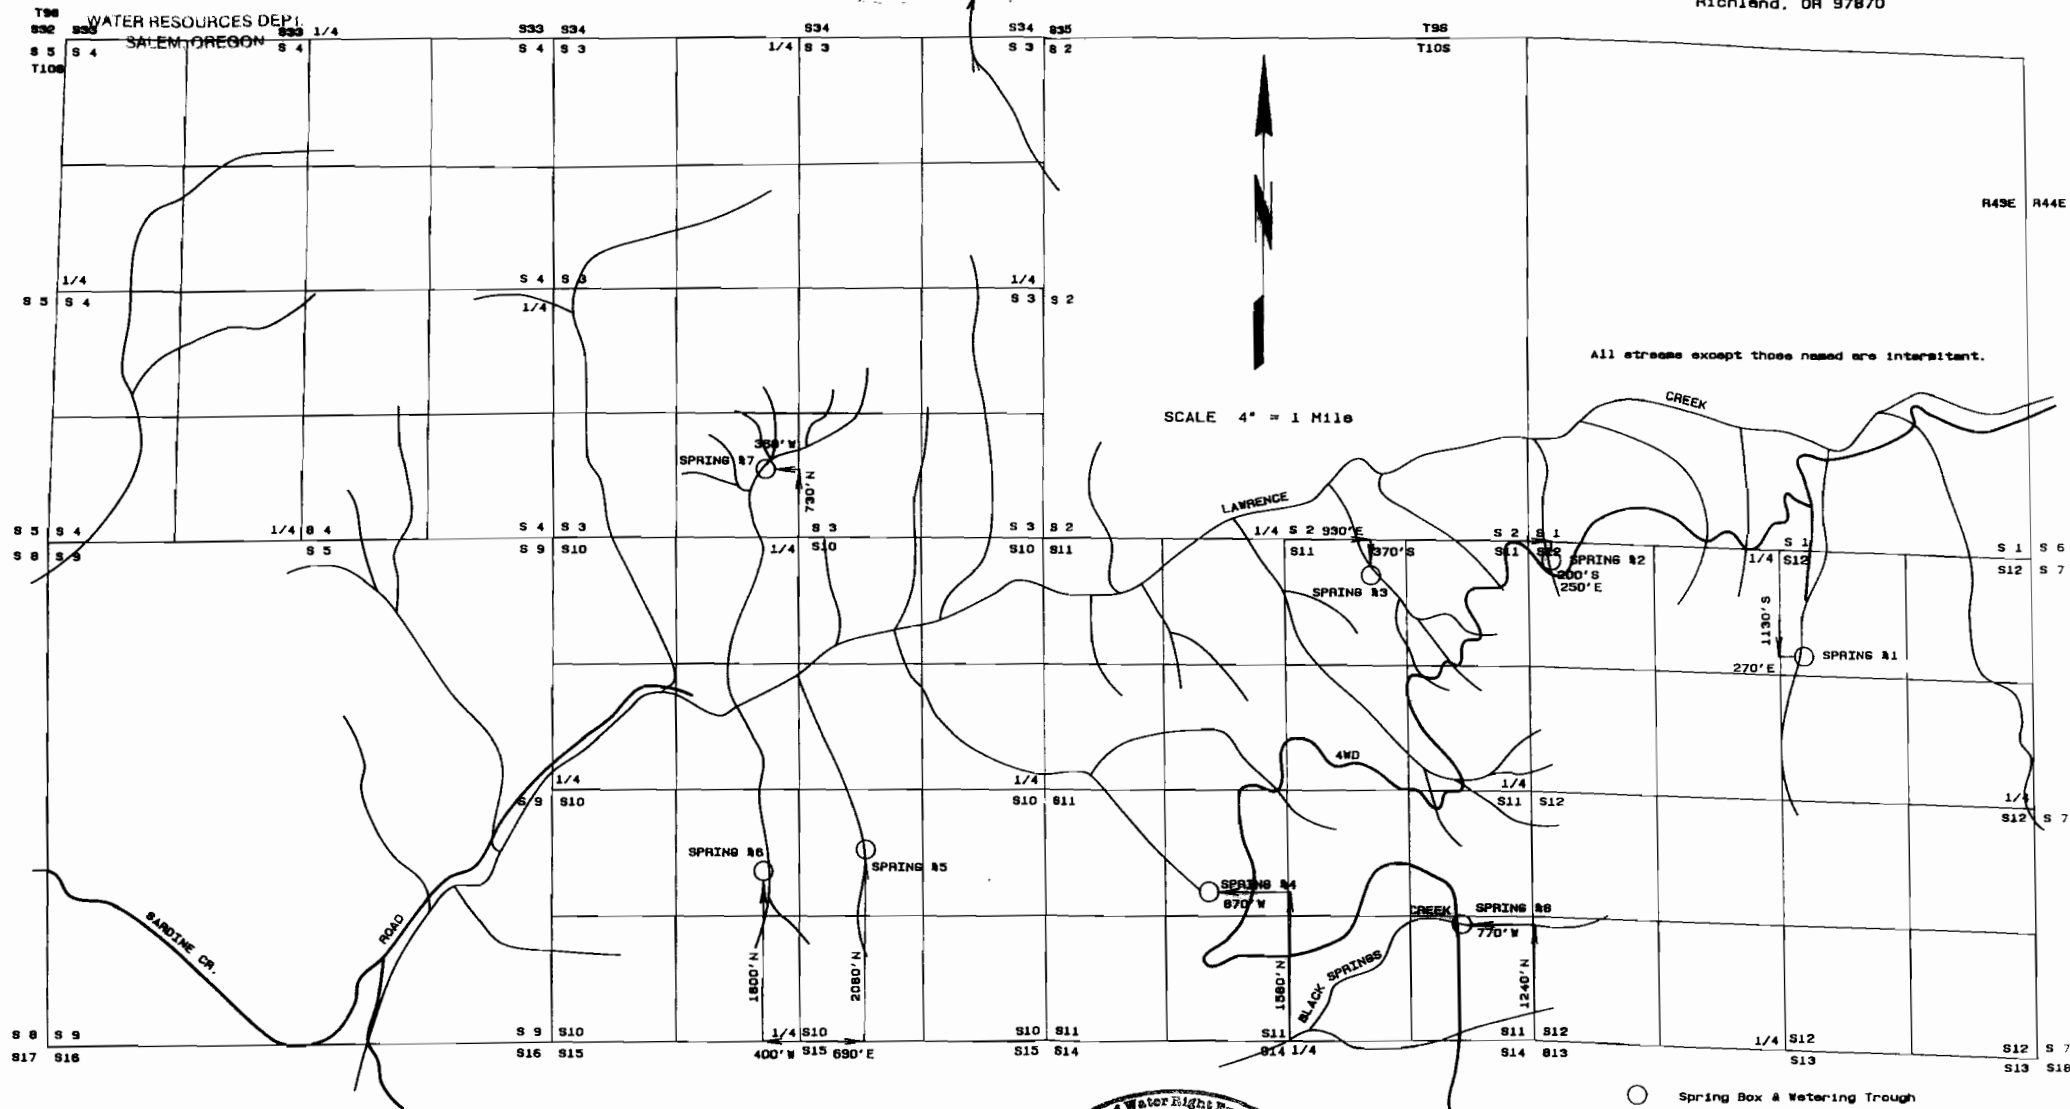

This map is for the purpose of identifying the location of the water right only and has no intent to provide dimensions or location of property ownership lines.

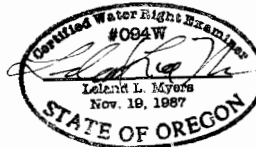

○ Spring Box & Watering Trough

Surveyed November 4, 1997