

CLAIM OF BENEFICIAL USE MAP


UNDER APPLICATION R-82507; PERMIT R-12264

SW1/4 NW1/4 SEC 36 T 27S R 44E W.M.

U.S.G.S. QUAD - MCCAIN CREEK, DREG - 7 1/2'

LEGEND

-  RESERVOIR NOT ON QUAD
-  CHANNEL
-  FD SEC COR

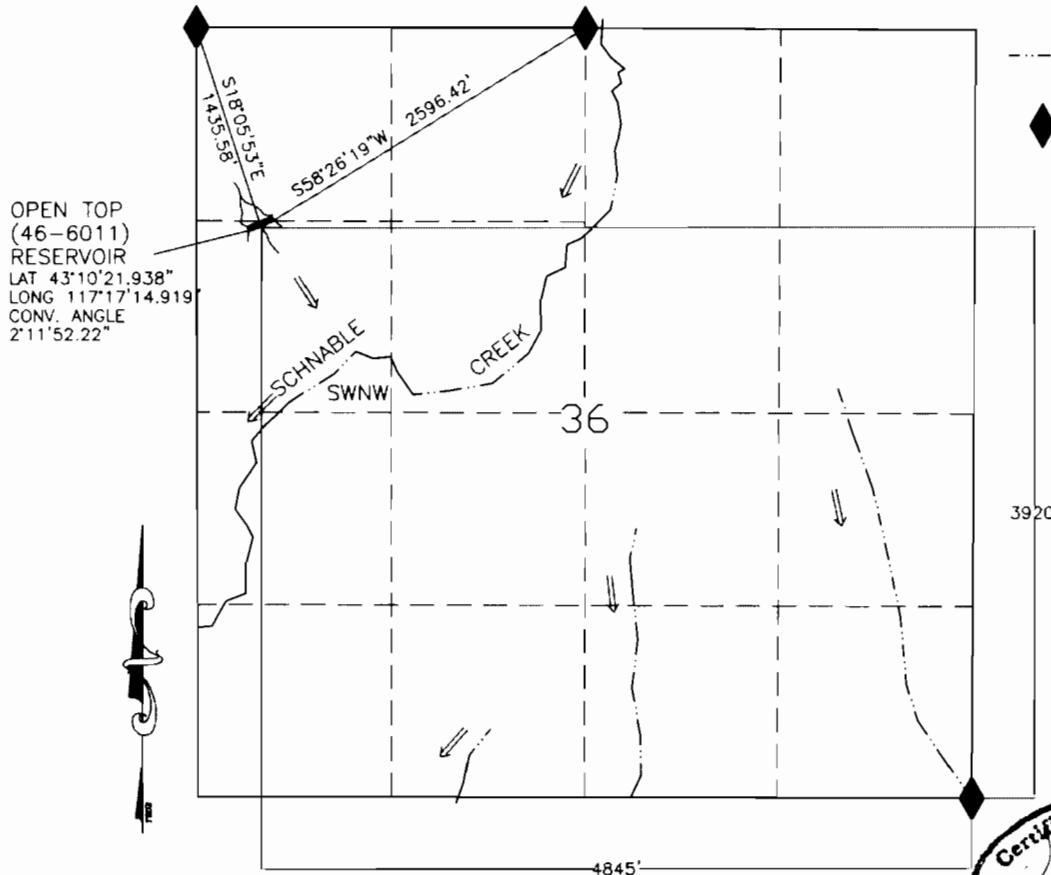

RECEIVED
OCT 8 1983
WATER RESOURCES DIV.
U.S. GEOLOGICAL SURVEY

Certified Water Right Examiner
#182
Vernon R. Pritchard
Vernon R. Pritchard
May 17, 1983
STATE OF OREGON
Expires 12/31/02

OPEN TOP (48-6011) RESERVOIR



SCALE 1"=1320'

I, *Jerry Carter* Acting ADM Operations/Field Services agree to the findings of the CWRE and do submit this site report and map as my Claim of Beneficial Use of the water as provided under the terms and conditions of my Permit R-12264.



THIS MAP IS FOR THE PURPOSE OF LOCATING A WATER RIGHT AND IS NOT INTENDED TO PROVIDE LEGAL DIMENSIONS FOR LOCATION OF PROPERTY BOUNDARIES.

ACAD2000
DWG FILE: OPENTOPBEN

UNITED STATES DEPARTMENT OF THE INTERIOR BUREAU OF LAND MANAGEMENT DIVISION OF OPERATIONS VALE DISTRICT	
DRAWN BY:	<i>Vernon R. Pritchard</i>
SURVEYED:	<i>Jerry Carter</i>
APPROVED:	<i>Jerry Carter</i>
DRAWN: CG	SCALE: 1"=1320'
DATE: 08/22/01	SHEET 1 OF 1
DRAWING NO. DR-03-9172.45-1089	