


LEGEND

- RESERVOIR NOT ON QUAD
- RESERVOIR SHOWN ON QUAD
- ROAD
- CHANNEL
- TRAIL
- COUNTY LINE
- MINE
- FD SEC CDR
- SPRING

CLAIM OF BENEFICIAL USE MAP

U.S.G.S. QUAD - MORMON BASIN, OREG. - 7 1/2'

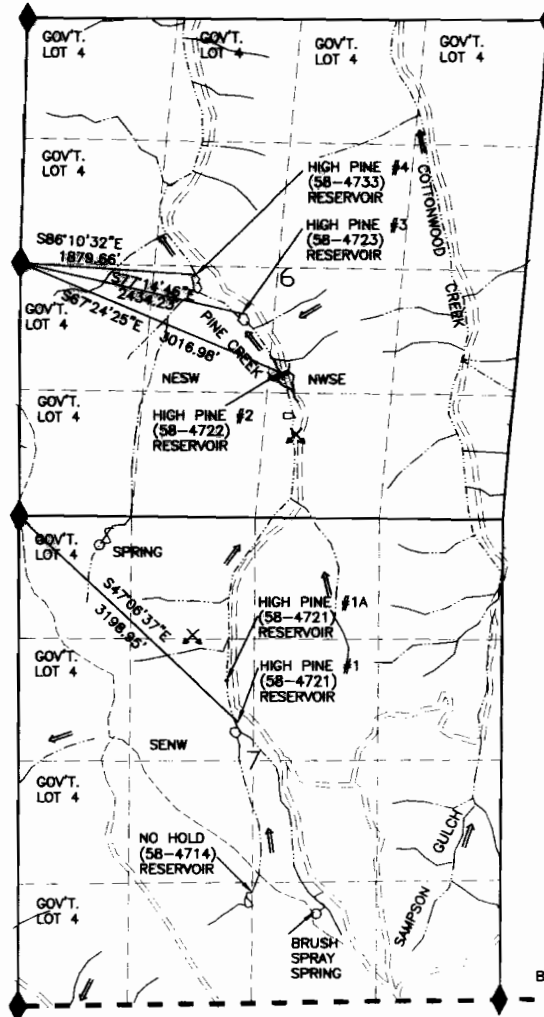

RECEIVED

OCT 11 2001

WATER RESOURCES DEPT.

BAKER COUNTY

MALHEUR COUNTY

APPLICATION R-82519 ; PERMIT R-12275
HIGH PINE #1 & HIGH PINE #1A (58-4721) RESERVOIRS
SE1/4 NW1/4 SECTION 7, T.13S., R.42E., W.M.
S47°06'37"E, 3198.95' FROM THE NW COR OF SAID SECTION 7

I, _____, Acting ADM Operations/Field Services
agree to the findings of the CWRE and do submit
this site report and map as my Claim of Beneficial
Use of the water as provided under the terms and
conditions of my Permit R-12275

APPLICATION R-82520 ; PERMIT R-12276
HIGH PINE #2 (58-4722) RESERVOIR
NW1/4 SE1/4 SECTION 6, T.13S., R.42E., W.M.
S67°24'25"E, 3016.98' FROM THE W1/4 COR OF SAID SECTION 6

I, _____, Acting ADM Operations/Field Services
agree to the findings of the CWRE and do submit
this site report and map as my Claim of Beneficial
Use of the water as provided under the terms and
conditions of my Permit R-12276


[Signature]

APPLICATION R-82521 ; PERMIT R-12277
HIGH PINE #3 (58-4723) RESERVOIR
NE1/4 SW1/4 SECTION 6, T.13S., R.42E., W.M.
S77°14'46"E, 2434.23' FROM THE W1/4 COR OF SAID SECTION 6

I, _____, Acting ADM Operations/Field Services
agree to the findings of the CWRE and do submit
this site report and map as my Claim of Beneficial
Use of the water as provided under the terms and
conditions of my Permit R-12277

APPLICATION R-82522 ; PERMIT R-12278
HIGH PINE #4 (58-4733) RESERVOIR
NE1/4 SW1/4 SECTION 6, T.13S., R.42E., W.M.
S86°10'32"E, 1879.65' FROM THE W1/4 COR OF SAID SECTION 6

I, _____, Acting ADM Operations/Field Services
agree to the findings of the CWRE and do submit
this site report and map as my Claim of Beneficial
Use of the water as provided under the terms and
conditions of my Permit R-12278

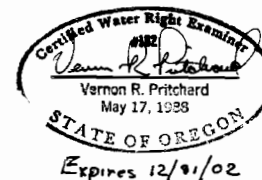

REV. NO.	DESCRIPTION	DATE	APPROVED
1	UNITED STATES DEPARTMENT OF THE INTERIOR BUREAU OF LAND MANAGEMENT DIVISION OF OPERATIONS		OREGON STATE OFFICE
BAKER RESOURCE AREA RESERVOIRS IN SEC 6 & 7, T.13S., R.42E., W.M. HIGH PINE #1-#4 RESERVOIRS			
DESIGNED	<i>[Signature]</i>		
REVIEWED	<i>[Signature]</i>		
APPROVED	<i>[Signature]</i>		
DRAWN: C.G.	SCALE: 1"=1320'		
DATE: 08/14/01	SHEET 1 OF 1		
DRAWING NO. OR-03-9172.45-1084			

1320 660 0 1320

SCALE 1"=1320'

THIS MAP IS FOR THE PURPOSE OF LOCATING
A WATER RIGHT AND IS NOT INTENDED TO
PROVIDE LEGAL DIMENSIONS FOR LOCATION
OF PROPERTY BOUNDARIES.