


LEGEND

- RESERVOIR NOT ON QUAD
- RESERVOIR SHOWN ON QUAD
- ROAD
- CHANNEL
- TRAIL
- COUNTY LINE
- MINE
- FD SEC COR
- SPRING

CLAIM OF BENEFICIAL USE MAP

U.S.G.S. QUAD - MORMON BASIN, OREG. - 7 1/2'

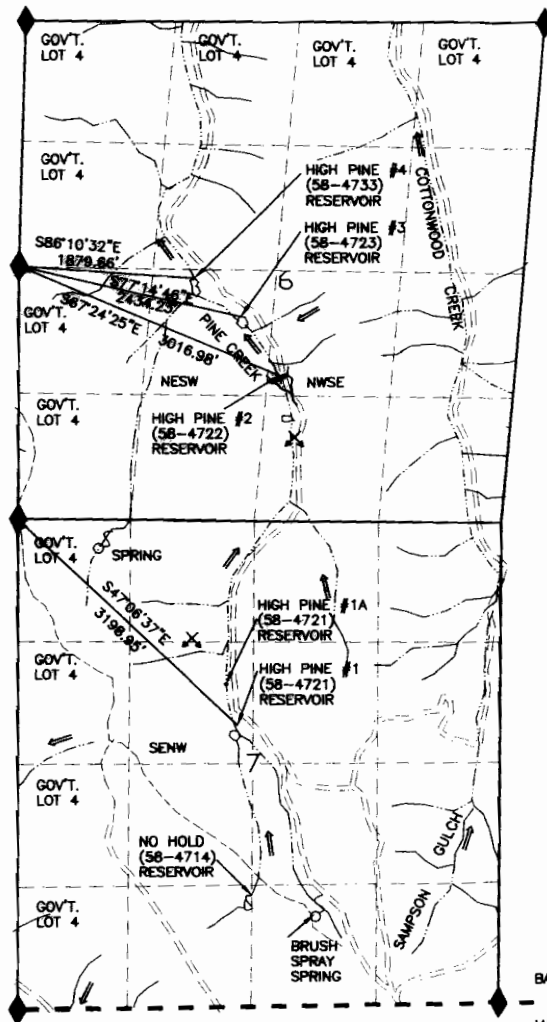

APPLICATION R-82519 ; PERMIT R-12275
HIGH PINE #1 & HIGH PINE #1A (58-4721) RESERVOIRS
SE1/4 NW1/4 SECTION 7, T.13S., R.42E., W.M.
S47°06'37"E, 3198.95' FROM THE NW COR OF SAID SECTION 7
I, _____, Acting ADM Operations/Field Services
agree to the findings of the CWRE and do submit
this site report and map as my Claim of Beneficial
Use of the water as provided under the terms and
conditions of my Permit R-12275

APPLICATION R-82520 ; PERMIT R-12276
HIGH PINE #2 (58-4722) RESERVOIR
NW1/4 SE1/4 SECTION 6, T.13S., R.42E., W.M.
S67°24'25"E, 3016.98' FROM THE W1/4 COR OF SAID SECTION 6
I, _____, Acting ADM Operations/Field Services
agree to the findings of the CWRE and do submit
this site report and map as my Claim of Beneficial
Use of the water as provided under the terms and
conditions of my Permit R-12276

APPLICATION R-82521 ; PERMIT R-12277
HIGH PINE #3 (58-4723) RESERVOIR
NE1/4 SW1/4 SECTION 6, T.13S., R.42E., W.M.
S77°14'48"E, 2434.23' FROM THE W1/4 COR OF SAID SECTION 6
I, _____, Acting ADM Operations/Field Services
agree to the findings of the CWRE and do submit
this site report and map as my Claim of Beneficial
Use of the water as provided under the terms and
conditions of my Permit R-12277

APPLICATION R-82522 ; PERMIT R-12278
HIGH PINE #4 (58-4733) RESERVOIR
NE1/4 SW1/4 SECTION 6, T.13S., R.42E., W.M.
S86°10'32"E, 1879.65' FROM THE W1/4 COR OF SAID SECTION 6
I, _____, Acting ADM Operations/Field Services
agree to the findings of the CWRE and do submit
this site report and map as my Claim of Beneficial
Use of the water as provided under the terms and
conditions of my Permit R-12278

1320 660 0 1320

SCALE 1"=1320'

THIS MAP IS FOR THE PURPOSE OF LOCATING
A WATER RIGHT AND IS NOT INTENDED TO
PROVIDE LEGAL DIMENSIONS FOR LOCATION
OF PROPERTY BOUNDARIES.

RECEIVED

SECT 8 - 200

UNITED STATES DEPT. OF THE INTERIOR
BUREAU OF LAND MANAGEMENT

BAKER COUNTY

MALHEUR COUNTY



REV. NO.	DESCRIPTION	DATE	APPROVED
	UNITED STATES DEPARTMENT OF THE INTERIOR BUREAU OF LAND MANAGEMENT DIVISION OF OPERATIONS		OREGON STATE OFFICE
	BANKER RESOURCE AREA RESERVOIRS IN SEC 6 & 7, T.13S., R.42E., W.M.		
	HIGH PINE #1-#4 RESERVOIRS		
DRAWN	C.G.		
DATE	06/15/01		
ORIGIN	NO. OR-03-9172.45-1084		