

RECEIVED

JUN 9 1999


WATER RESOURCES DEPT.
SALEM, OREGON

FINAL PROOF MAP

UNDER

Application No. R-71727 Permit No. R-11816

IN THE NAME OF: Robert & Caroline Estill
1211 Plantation Meadows Dr.
Richmond, Texas 77469

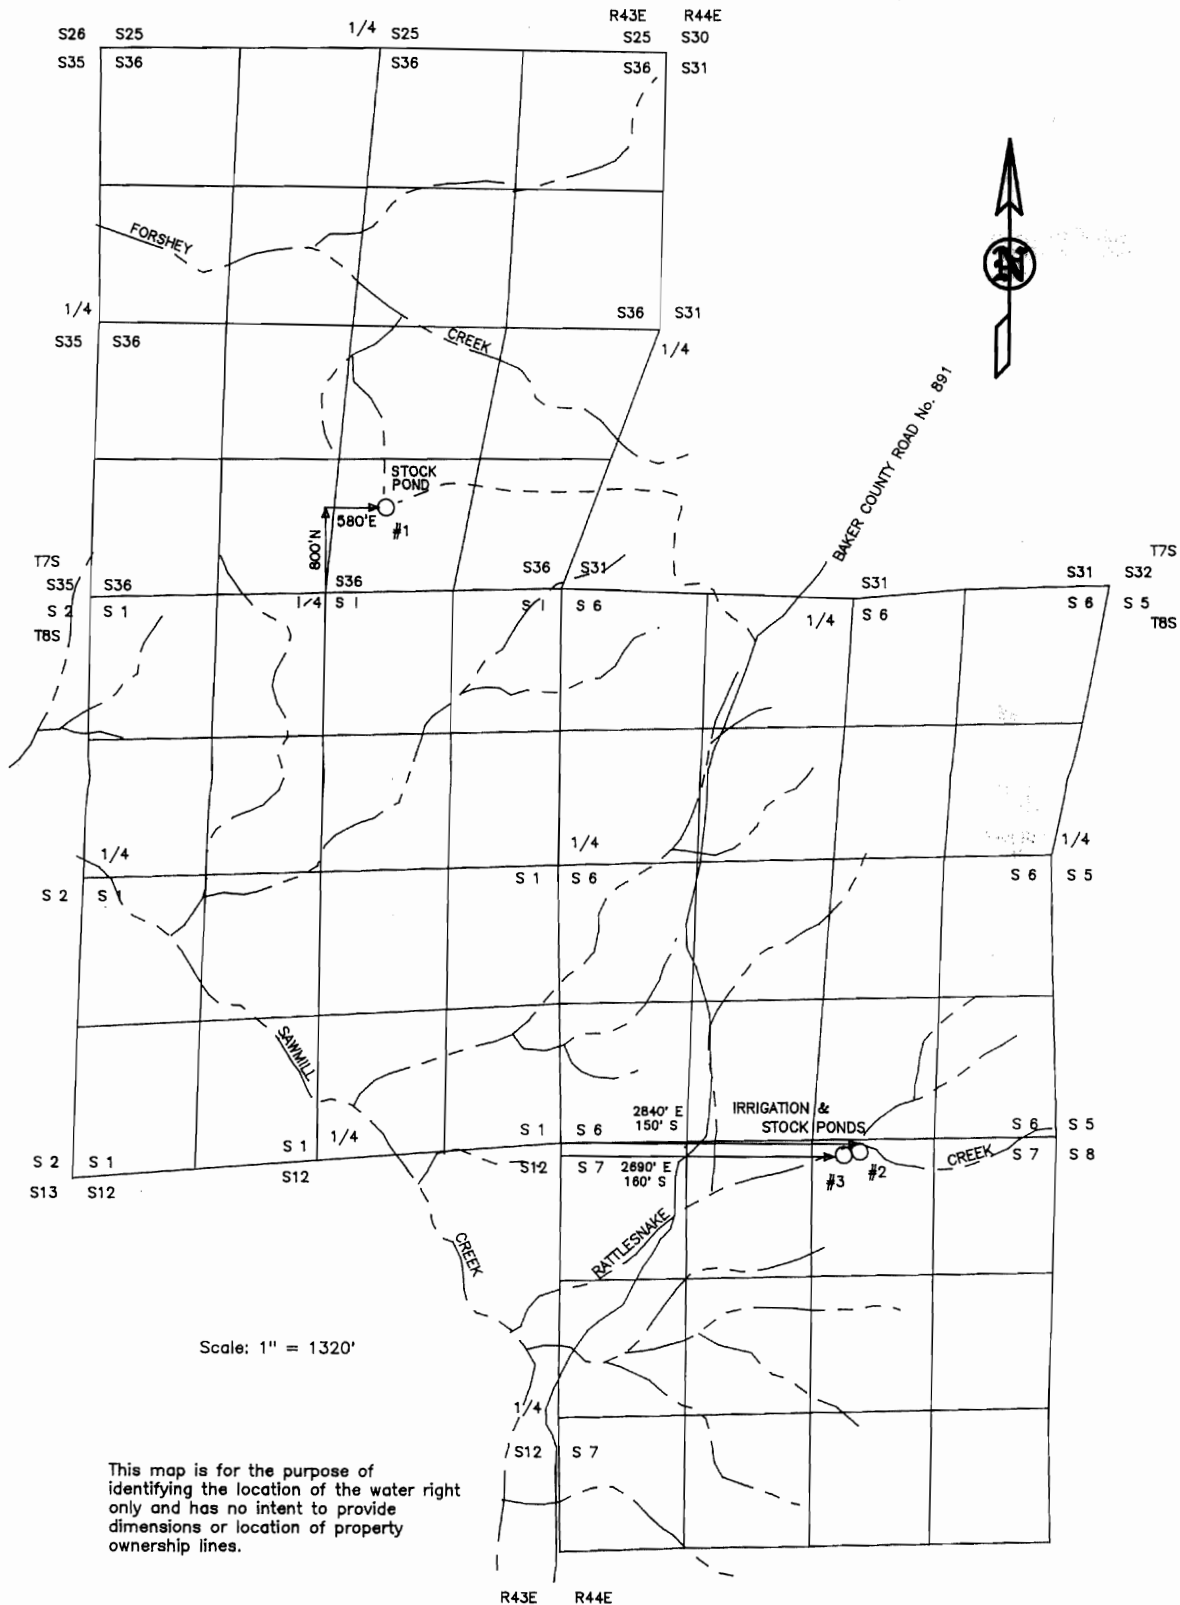

This map is for the purpose of identifying the location of the water right only and has no intent to provide dimensions or location of property ownership lines.

