



T. 26 S., R. 7 W., W. M.

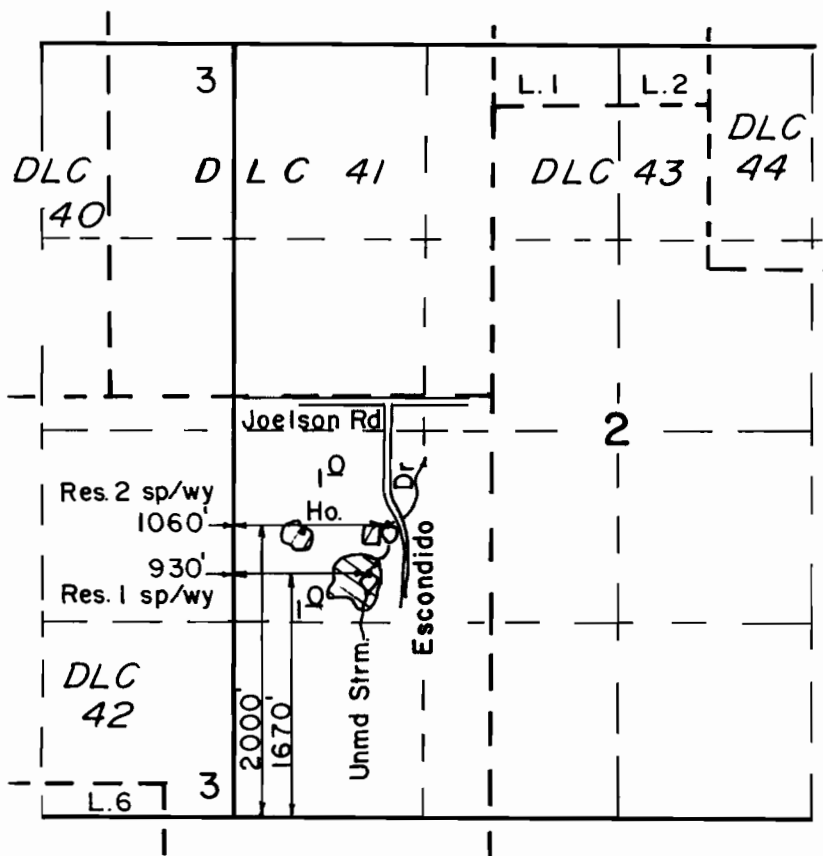

Scale: 1" = 1320'

FINAL PROOF SURVEY UNDER

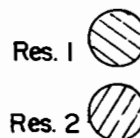

R-66945 R-9601
Application No. ~~66946~~ Permit No. ~~48337~~....
IN NAME OF

.....
Surveyed AUG. 23. 1990., by R.S. JAMES.....