



T. 26 S., R. 7 W., W. M.

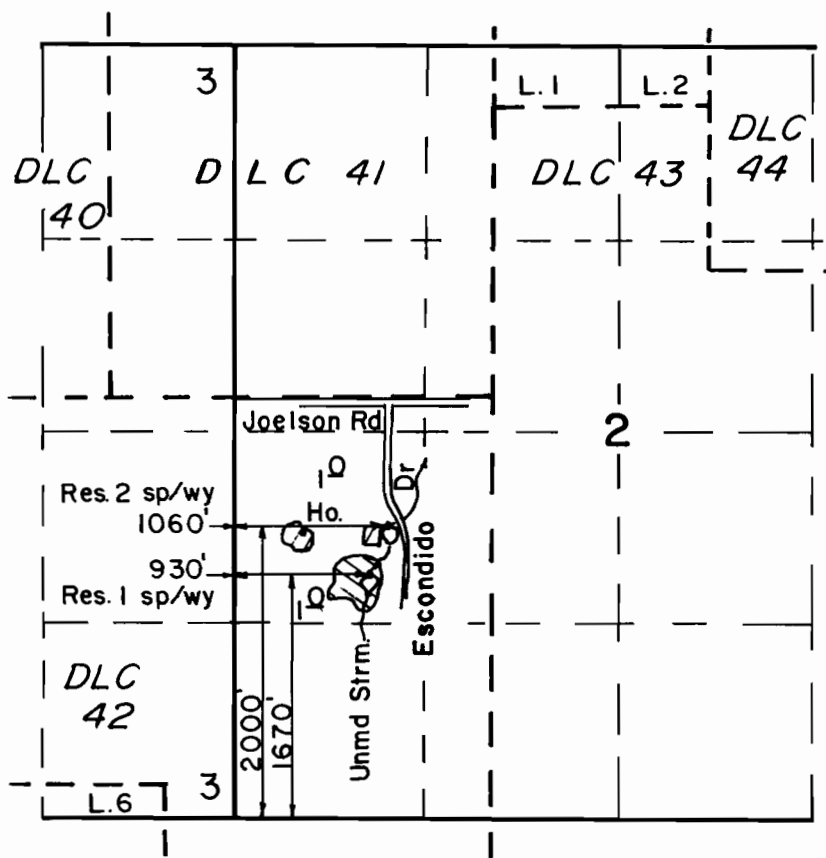

Scale: 1" = 1320'

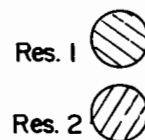

FINAL PROOF SURVEY **UNDER**

R-66945 R-9601
Application No. ~~66945~~ Permit No. ~~48337~~....
IN NAME OF

.....
Surveyed AUG.23. 1990., by R.S. JAMES.....