
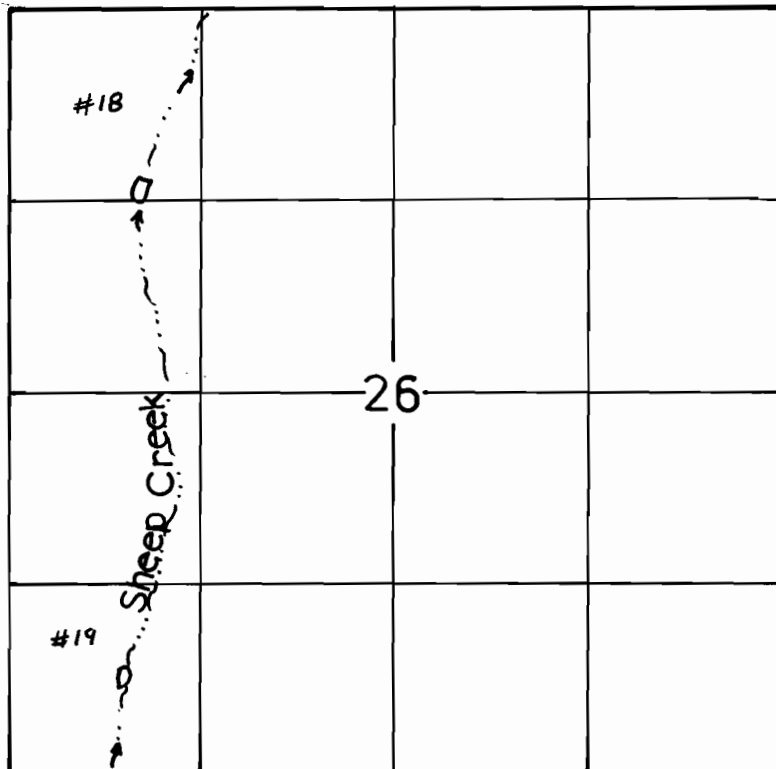
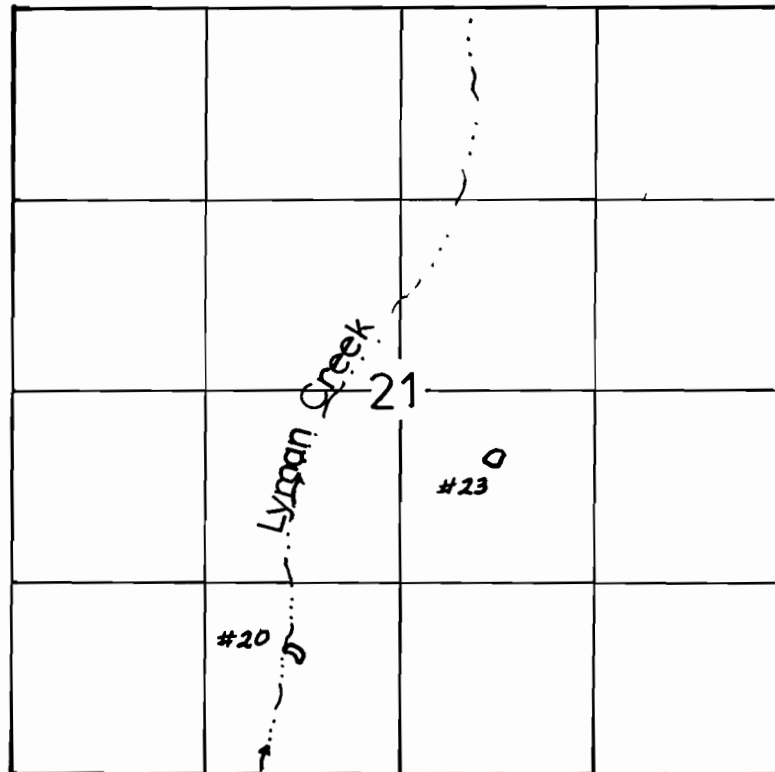


T.15 S., R. 40 E., W.M.

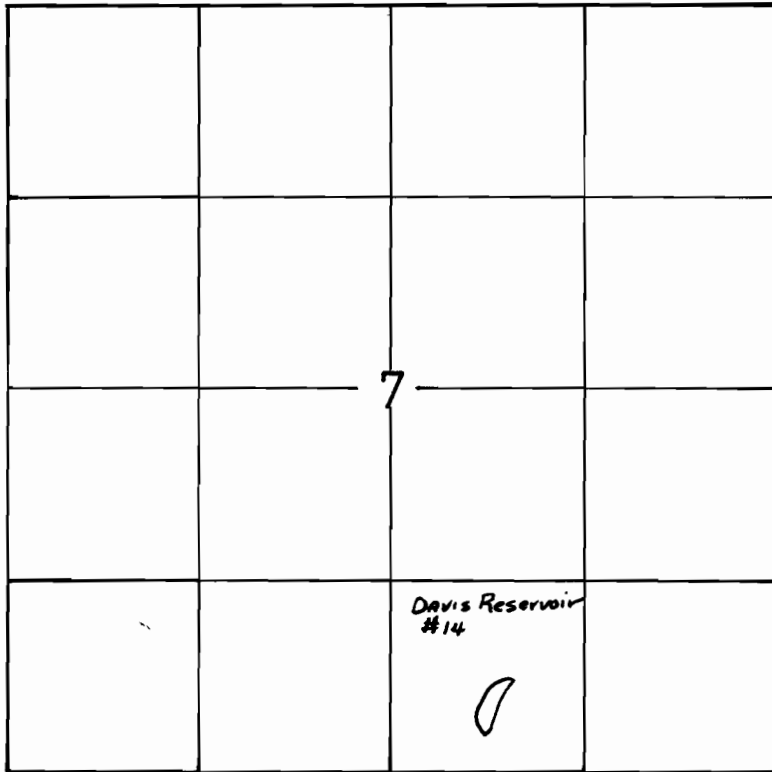

1" = 1320'

**FINAL PROOF SURVEY**  
UNDER

|                       |                  |
|-----------------------|------------------|
| Application N. R37354 | Permit N. R 6720 |
| R37358                | R 6722           |
| R37359                | R 6723           |
| R37360                | R 6724           |
| R37363                | R 6725           |

IN NAME OF  
EUGENIE (MRS. GUSS) DAVIS

Surveyed 7-26-1990, by K. RISE