
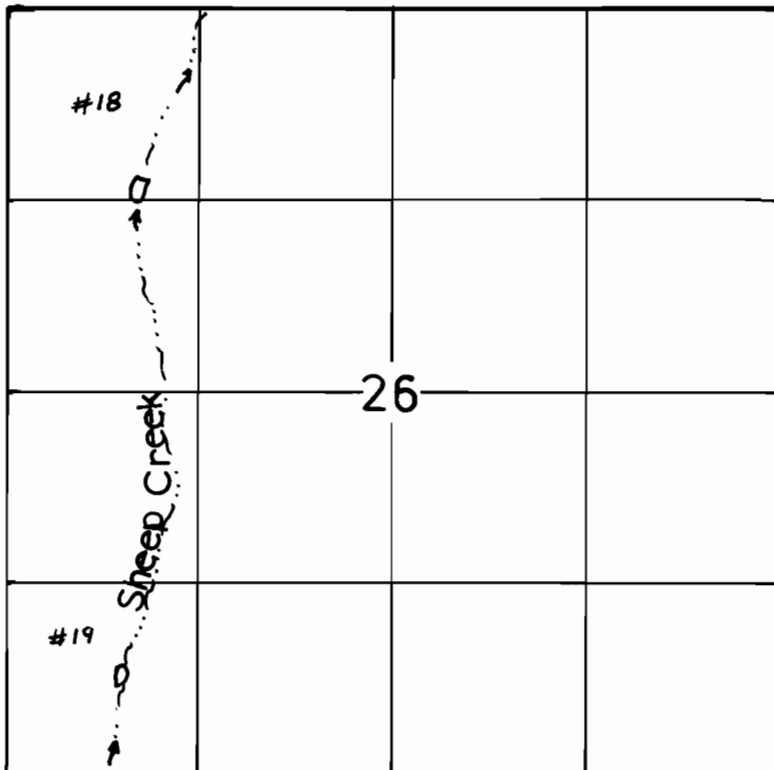
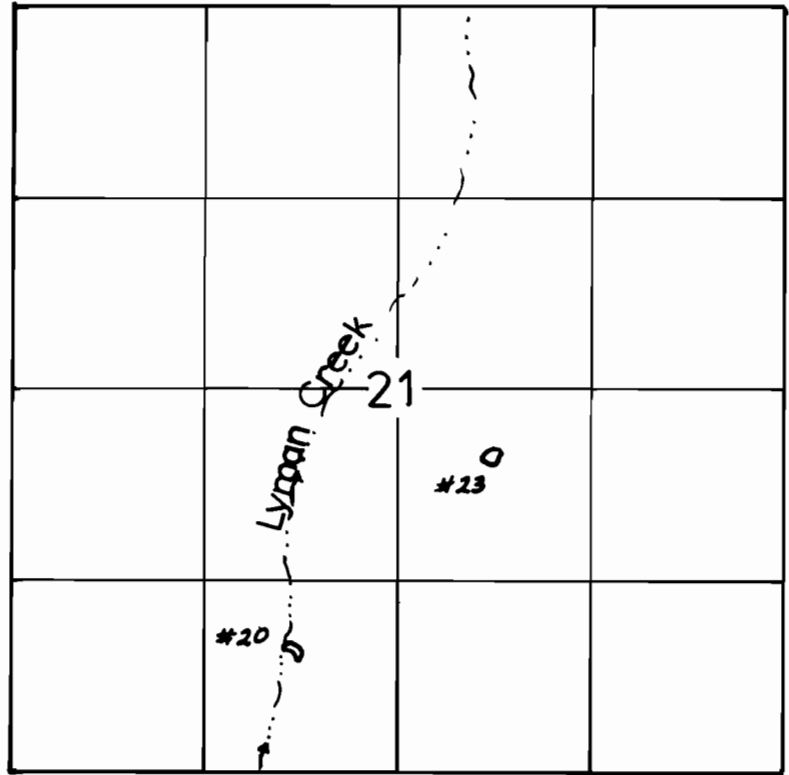


T.15 S., R. 40 E., W.M.

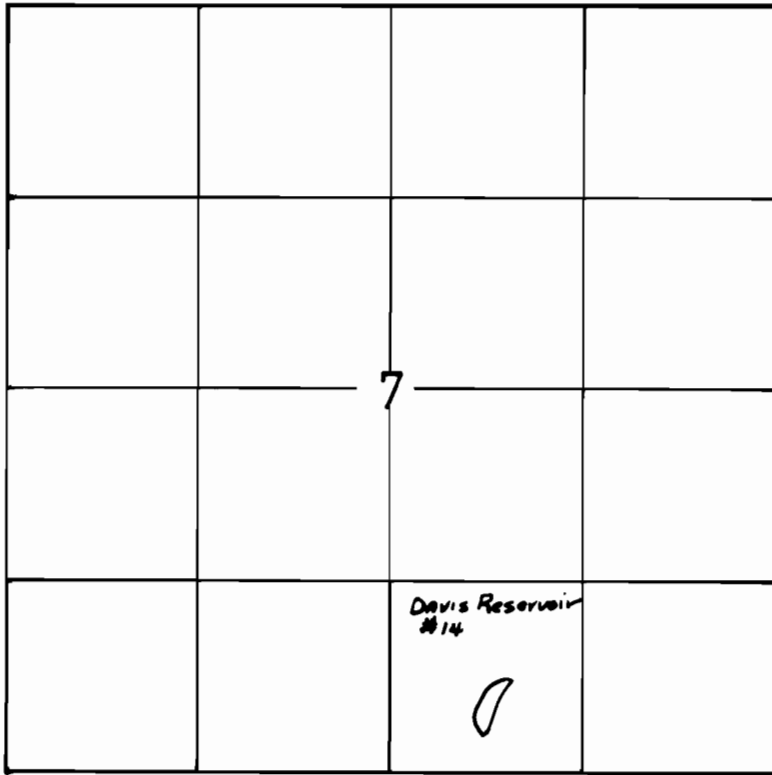

1" = 1320'

FINAL PROOF SURVEY
UNDER

Application N. R37354 Permit N. R 6720
R37358 R 6722
R37359 R 6723
R37360 R 6724
R37363 R 6725

IN NAME OF
EUGENIE (MRS. GUSS) DAVIS

Surveyed 7-26-1990, by K. RISE