


# T.3S., R.1W., W.M

RECEIVED  
MAR 01 2005  
WATER RESOURCES DEPT  
SALEM, OREGON

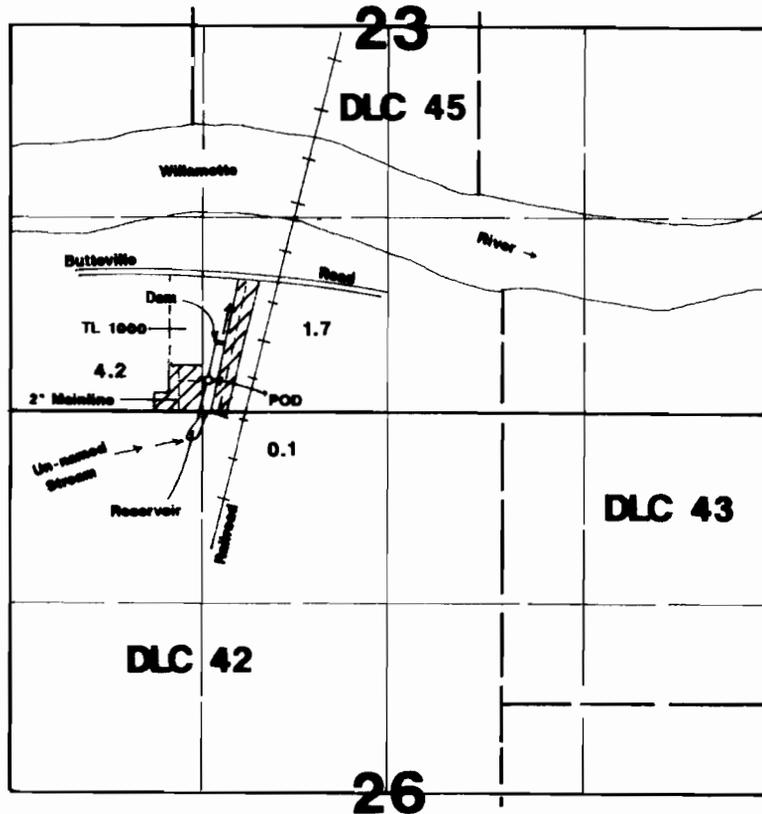

Dam is located 480'N & 1490'E  
POD is located 200'N & 1440'E both from the SW corner of Section 23.

## Final Proof Survey

In Name Of

# David Bernert

Application #: R-74022  
S-78402

Permit #: R-12169  
53117

Surveyed on August 11, 2004 by JM Schuette

This Map Was Prepared For The Purpose Of Identifying The Location Of A Water Right Only And Is Not Intended To Provide Legal Dimensions Or Location Of Property Ownership Lines.

