


T. 41 S., R. 15 E., W.M.

DIVERSION IS LOCATED
530 FT EAST AND
1230 FT. SOUTH OF THE
NW COR. OF SECTION 7

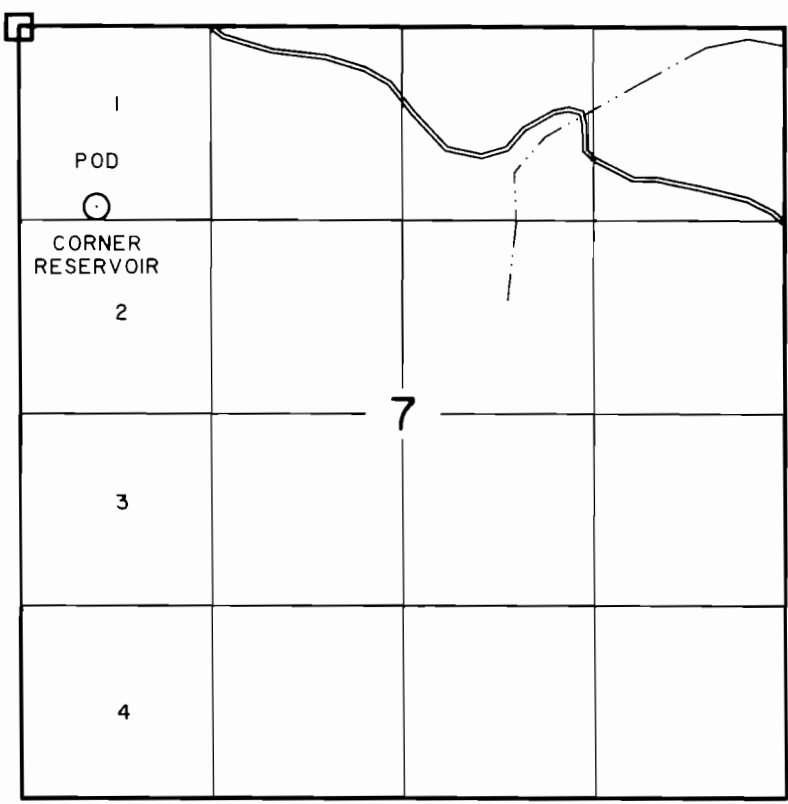

CLAIM OF BENEFICIAL USE MAP

IN NAME OF

UNITED STATES BUREAU OF LAND MANAGEMENT


APPLICATION NO. R-83418

PERMIT NO. R-12521

RECEIVED

MAY 9 5 2003

WATER SOURCES DIV.
STATE OF OREGON

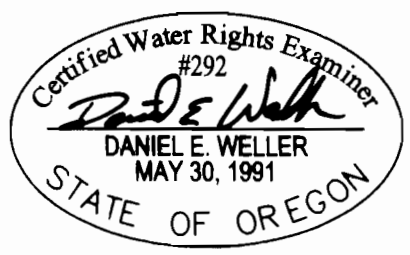

EXPIRES: JUNE 30, 2004

SURVEYED: MAY 7, 2001

THE PURPOSE OF THIS MAP IS FOR IDENTIFYING THE LOCATION OF THE WATER RIGHT ONLY AND IS NOT INTENDED TO PROVIDE LEGAL DIMENSIONS OR LOCATION OF PROPERTY OWNERSHIP LINES.

BLM PROJECT NO. OR-010-R-6527

U.S. BUREAU OF LAND MANAGEMENT-OSO
BRANCH OF CADASTRAL SURVEY
DWG: CORNER

EXECUTED BY:
DANIEL E. WELLER, PLS, CWRE #292
P.O. BOX 10226
EUGENE, OREGON 97440