


T. 39 S., R. 13 E., W.M.

DIVERSION IS LOCATED
420 FT EAST AND
40 FT SOUTH OF THE
N 1/4 OF SEC. 4.

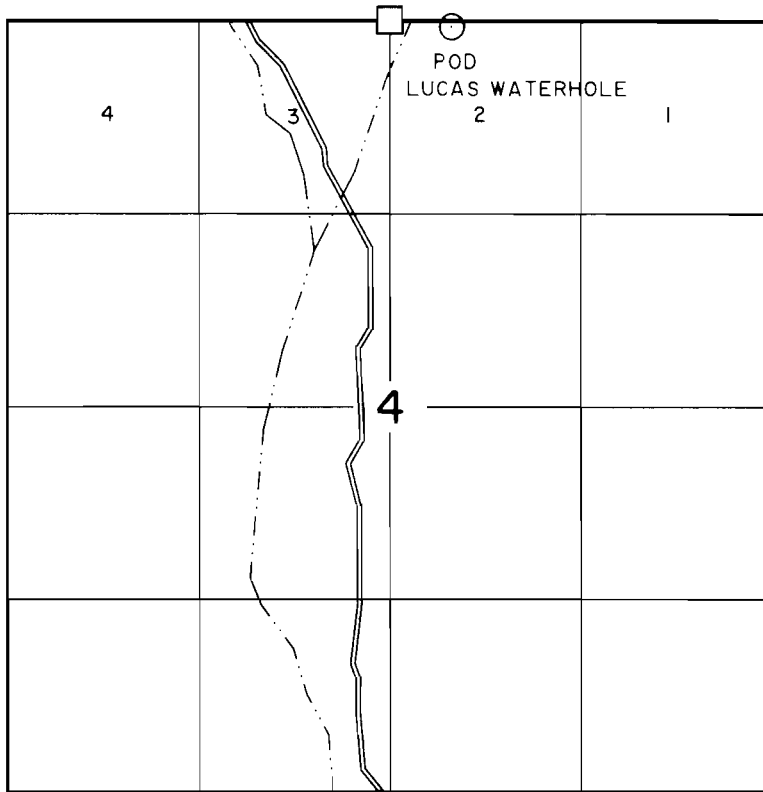

1" = 1320'


CLAIM OF BENEFICIAL USE MAP

IN NAME OF

UNITED STATES BUREAU OF LAND MANAGEMENT

APPLICATION NO. R-83419

PERMIT NO. R-12522

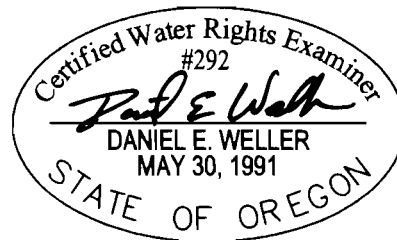

RECEIVED

MAY 15 2003

WATER RESOURCES DEPT
SALEM, OREGON

EXPIRES: JUNE 30, 2004

SURVEYED: MAY 7, 2001

THE PURPOSE OF THIS MAP IS FOR IDENTIFYING THE LOCATION OF THE WATER RIGHT ONLY AND IS NOT INTENDED TO PROVIDE LEGAL DIMENSIONS OR LOCATION OF PROPERTY OWNERSHIP LINES.

BLM PROJECT NO. OR-010-R-6526

U.S. BUREAU OF LAND MANAGEMENT-OSO
BRANCH OF CADASTRAL SURVEY
DWG: LUCAS

EXECUTED BY:
DANIEL E. WELLER, PLS, CWRE #292
P.O. BOX 10226
EUGENE, OREGON 97440