

WELL A  
 LOCATED IN LOT 52  
 LOCATED 2203' E. AND 49' N.  
 FROM W 1/4 CORNER OF SECTION  
 16, T.15S., R.16E., W.M. CROOK  
 COUNTY, OR

# HIGH DESERT ESTATES FINAL PROOF SURVEY

LOCATED IN THE SW 1/4 OF SECTION 16,  
 AND IN THE W 1/2 OF SECTION 21,  
 TOWNSHIP 15 SOUTH, RANGE 16 EAST, W.M.,  
 CROOK COUNTY, OREGON

HIGH DESERT ESTATES  
 GROUNDWATER APPROPRIATION  
 FILE: G-12796


MARK FLEMING  
 CROWN PACIFIC LTD.  
 403820 ELLIOTT LANE  
 PRINEVILLE, OR 97754

LOTS 1-22, HIGH DESERT ESTATES, PHASE ONE  
 LOTS 23-59, HIGH DESERT ESTATES, PHASE TWO

I, William R. Tye, Certified Water Right Examiner  
 in the State of Oregon, hereby certify the above  
 final proof survey was prepared under my direct  
 supervision.

The preparation of this map is for the purpose  
 of identifying the location of the water right only  
 and has no intent to provide dimensions or locations  
 of property ownership lines

The dimensions and property locations for the  
 High Desert Estates, Phases I and II, were  
 provided by Armstrong Surveying and Engineering, Inc.

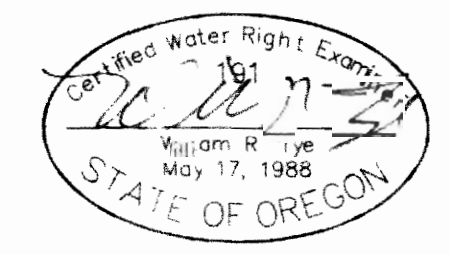

**TYE ENGINEERING, INC.**  
 725 NW HILL - BEND, OREGON 97701 - (503) 389-6959

TITLE:  
 HIGH DESERT ESTATES PHASE III  
 FINAL PROOF MAP

FOR:  
 MARK FLEMING  
 403820 ELLIOTT LANE  
 PRINEVILLE, OR 97754

SHEET 1 OF 1 SHEETS  
 DWG NAME: 169-22C

SCALE: 1"=400'  
 DATE: September 1, 2000  
 DRAWN: P.A.T.  
 DWG #: 169

CORR MAP # 0076