


T.24S., R.5W., W.M.

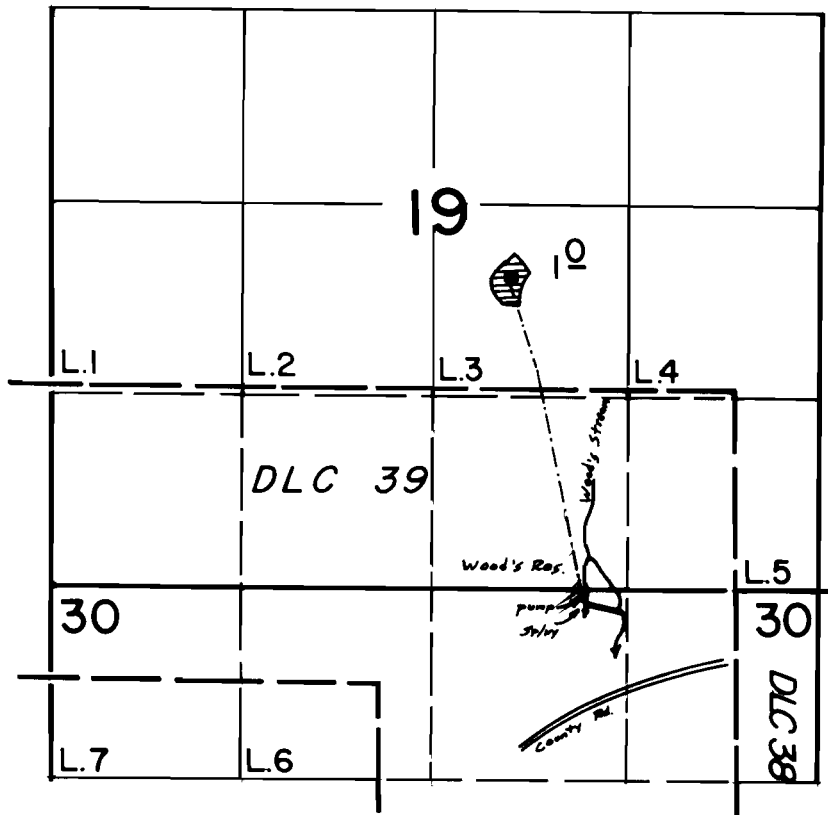

DIV. FT. : 20' SOUTH & 1580' WEST FROM THE NORTHEAST COR. SEC. 30.

Scale : 1" = 1320'

FINAL PROOF SURVEY UNDER

R-68700 R-10822
Application No. 68701 Permit No. 49960....
IN NAME OF

.....BILL.....R.....WOODS.....

Surveyed Sept. 19, 1991, by S. James.....