

RECEIVED

FINAL PROOF MAP

JAN 2 1998



UNDER APPLICATION No. R-71111, PERMIT No. R-11867 WATER RESOURCES DEPT.
SALEM, OREGON



Applicant:

Walter S. Saunders, Jr.
Route 1 Box 21
Richland, OR 97870

Scale 1" = 1320'

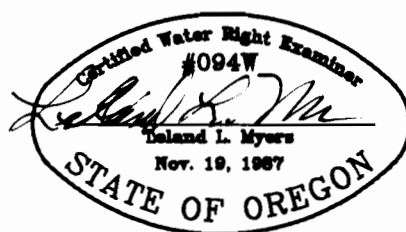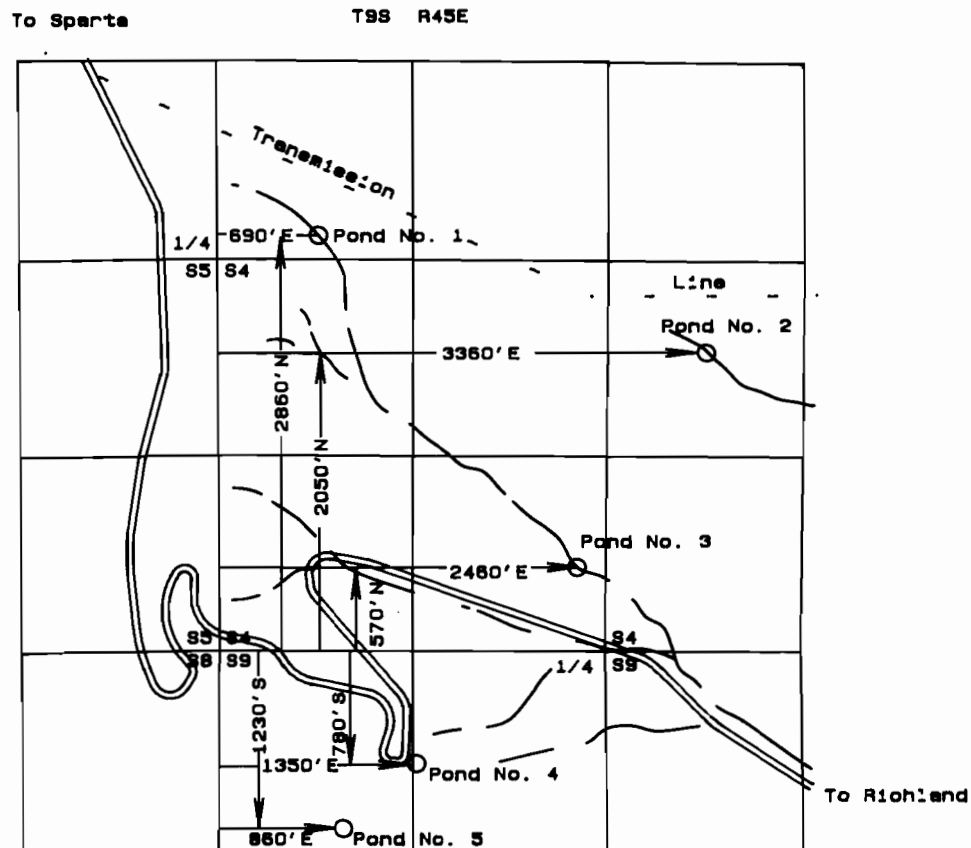

This map is for the purpose of identifying the location of the water right only and has no intent to provide dimensions or location of property ownership lines.