


Township 23 South, Range 31 East, W.M.
Section 10

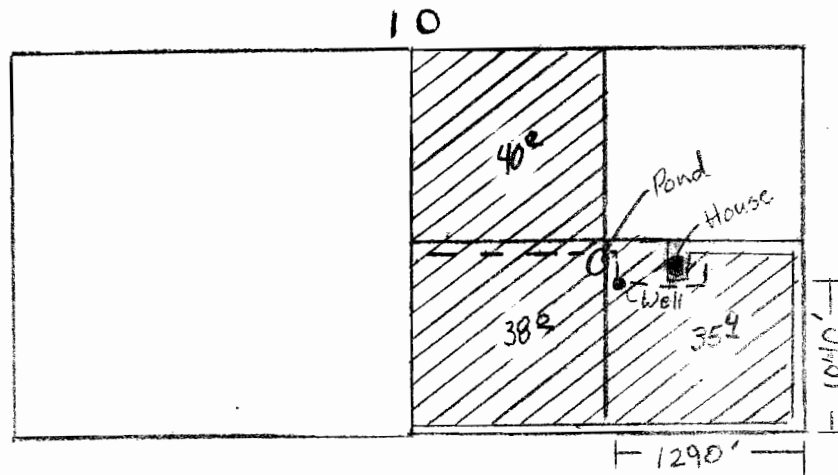

Final Proof Survey

Under

Application No. G-7910 Permit No. G-7212

In the Name of

George H. Bradach

Surveyed June 5, 2003, by June Miller

Gerry Clark