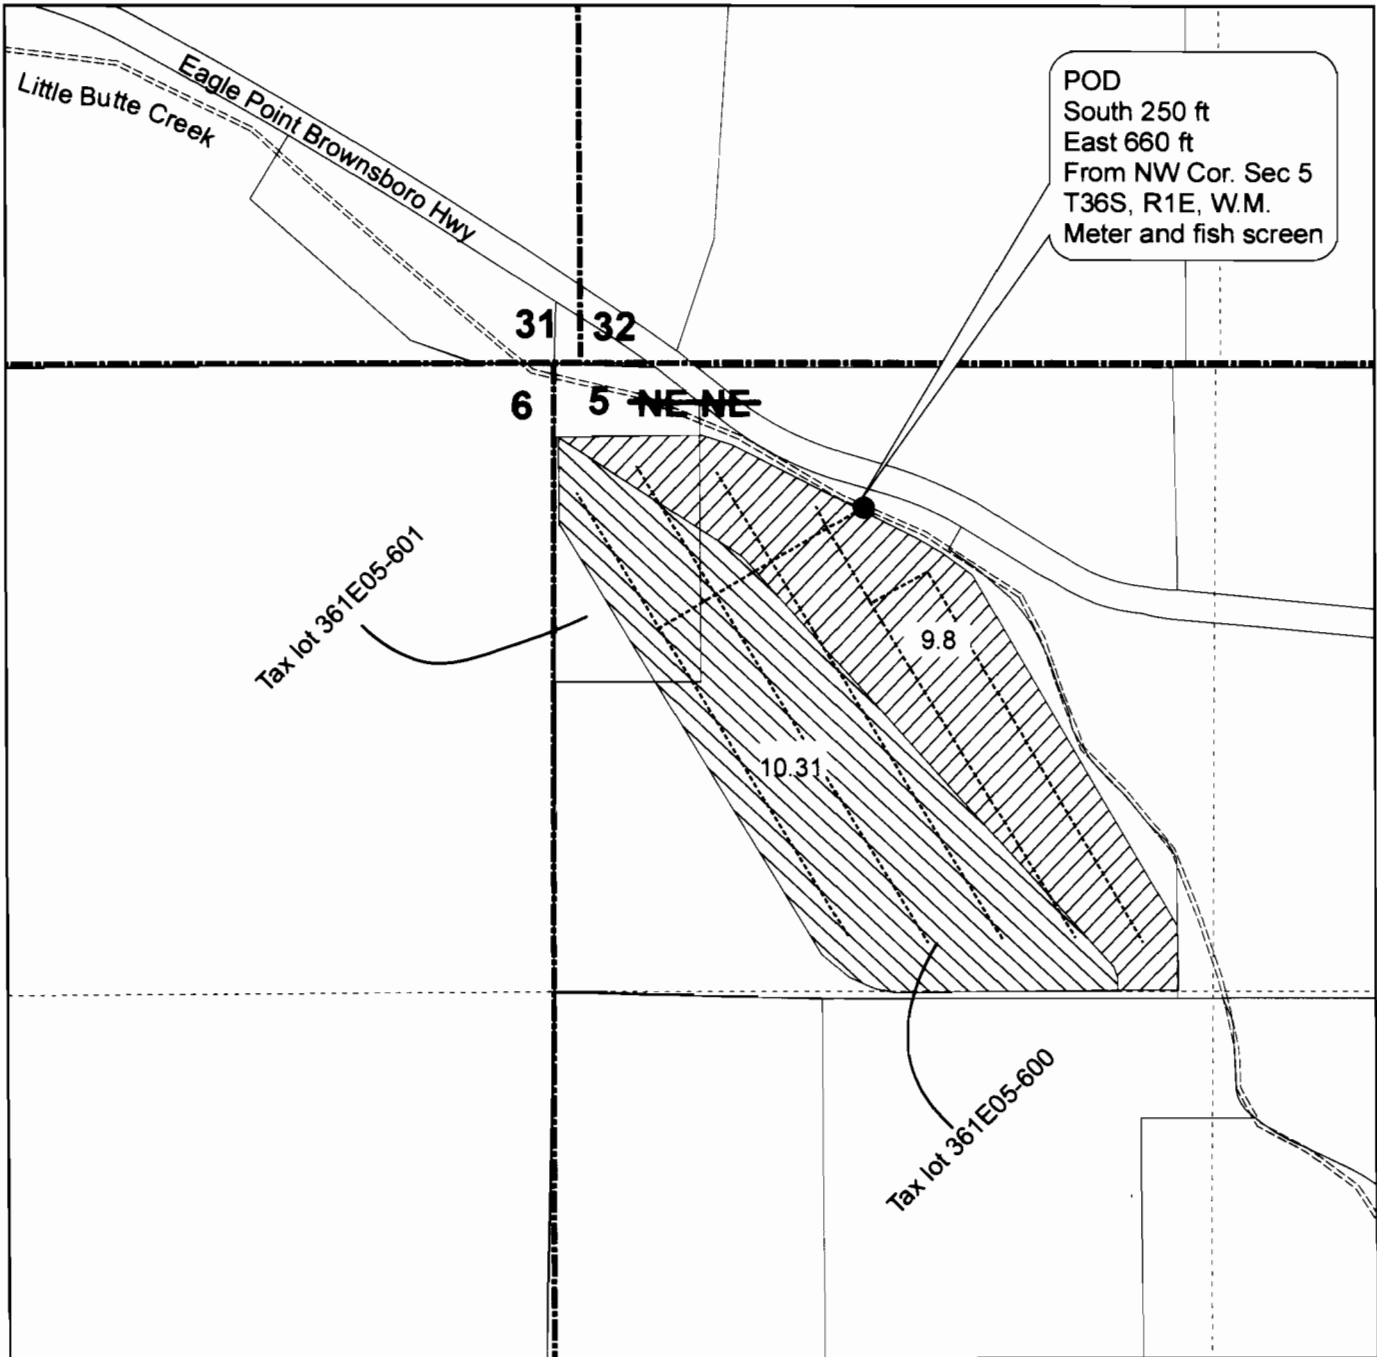


Claim of Beneficial Use Map

William Morgan

T-8830

T 36 S, R 1 E, Sec 5, W.M.


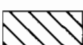
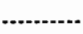


RECEIVED

AUG 18 2008

WATER RESOURCES DEP.
SALEM, OREGON

Legend

-  C17165 1885
-  C17165 1908
-  Pipeline



RENEWAL DATE 12-31-09

This map is not intended to provide legal dimensions or locations of property ownership lines.

N



0

400 Feet

FARBER
SURVEYING

PO Box 5286
Central Point, Oregon 97502
Phone 541-664-5599
Fax 541-664-5603
Email hfarber@charter.net

Farber & Sons, Inc.
431 Oak Street
Central Point, Oregon
Tax ID: 93-1057173