


RECEIVED

SEP 22 1999

WATER RESOURCES DEPT.
SALEM, OREGON

T13S, R1W, W.M.

SECTION 16

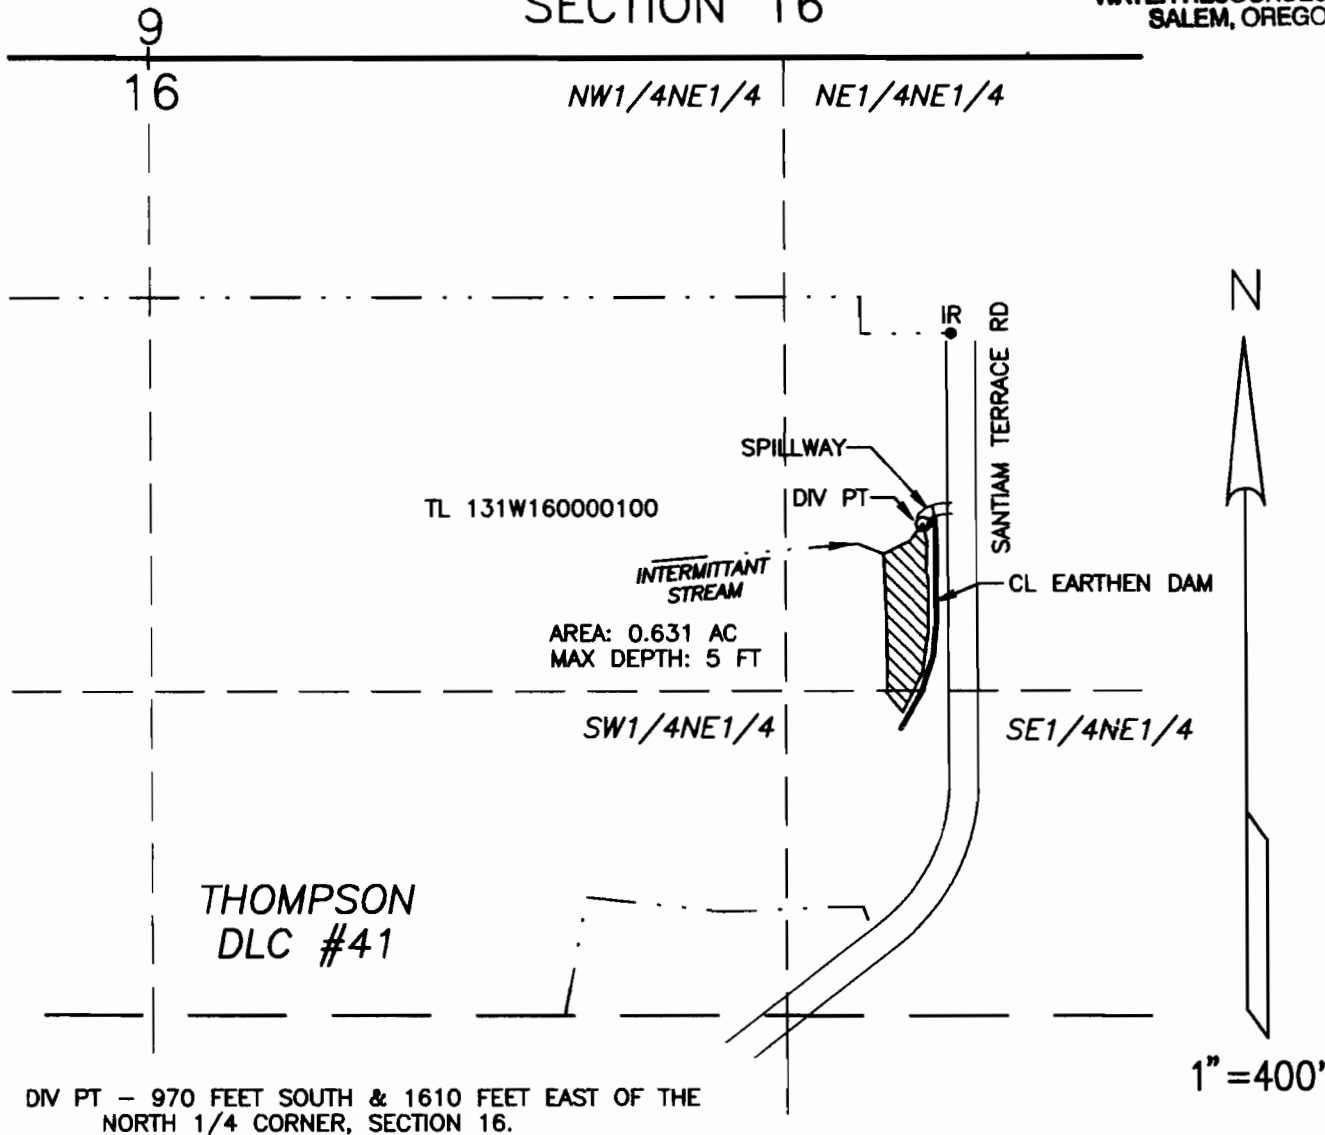

CLAIM OF BENEFICIAL USE MAP

IN THE NAME OF

KEVIN & JUDY OSBORNE


(ORIGINALLY DR KEITH & JUNE FLESHMAN)

APPLICATION R-73502

PERMIT R-11598

Prepared September 15, 1999
PARSONS SURVEYING
1915 S.E. Stone St.
Corvallis, OR 97333
(503) 752-7515
Project No. 9946

This map is for location of Water Right Application
only and does not constitute a boundary survey.

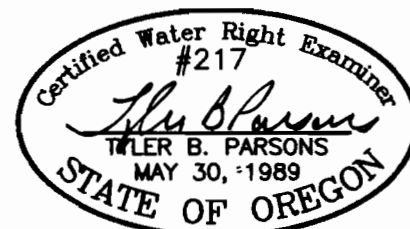

EXP: 12/31/2000