



CLAIM OF BENEFICIAL USE AND SITE REPORT
LOCATED IN THE SW¼ SE¼ OF SECTION 7
TOWNSHIP 23 SOUTH, RANGE 12 WEST, W.M.
COOS COUNTY, OREGON
APPLICATION R-73882 PERMIT R-12243

PREPARED FOR: AL JENSEN
PREPARED BY: DENNIS GOUDE
DATE PREPARED: SEPTEMBER 9, 2004


NOTE:
P.O.D. 1 IS LOCATED 499.9 FEET NORTH
AND 8.7 FEET WEST AND P.O.D. 2 IS
LOCATED 588.8 FEET NORTH AND 61.8 FEET
WEST OF THE EAST 1/16 CORNER OF SECTION 7

NOTE:
P.O.D. 1 & P.O.D. 2 ARE IN CHANNEL RESERVOIRS
CONSTRUCTED FOR WETLAND USE.

Scale 1"=400'

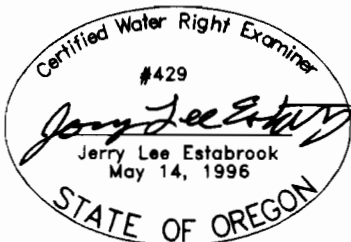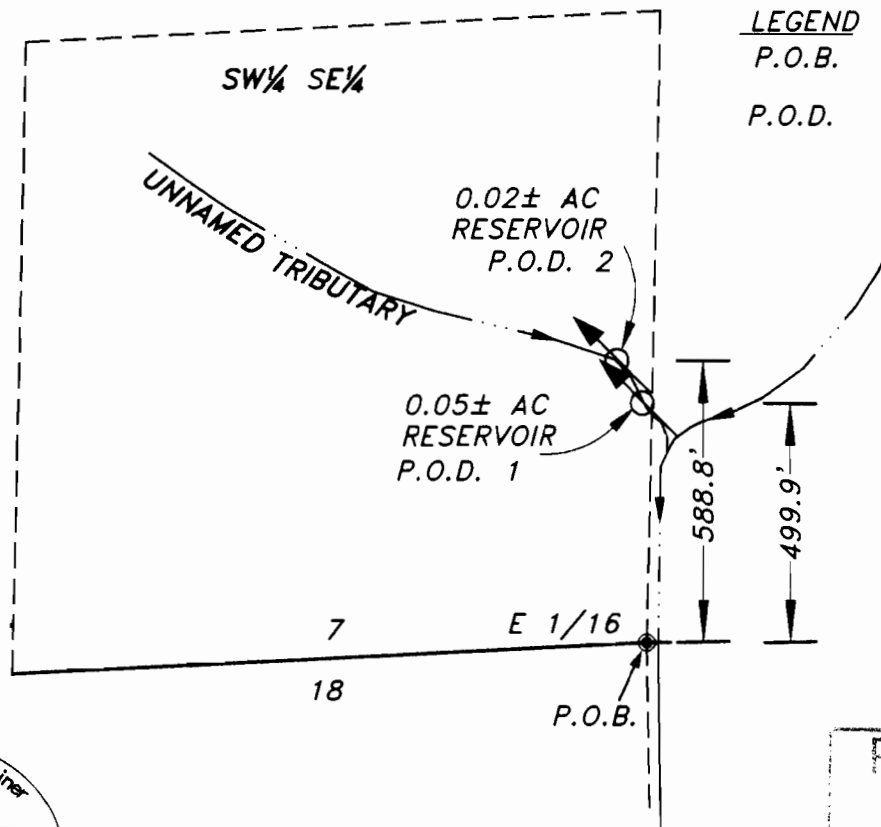

EXPIRES 12/31/2005

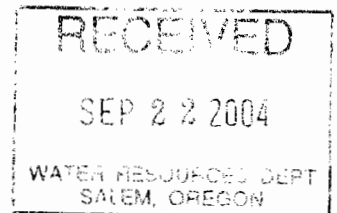

EXAMINERS DISCLAIMER STATEMENT
The preparation of this map was for the purpose of
identifying the location of the Water Right only and
has no intent to provide dimensions or location of
property ownership lines.

**Stutzner Engineering
& Forestry, L.L.C.**

ENGINEERING • LAND SURVEYING • FORESTRY
PLANNING • WATER RIGHTS

705 South 4th St.
Post Office Box 118
Coos Bay, Oregon 97420

Phone: (541) 287-2872
Fax: (541) 287-0588