


S1/2SE1/4 Section 20, T.37 S.,R.6 W.,W.M.

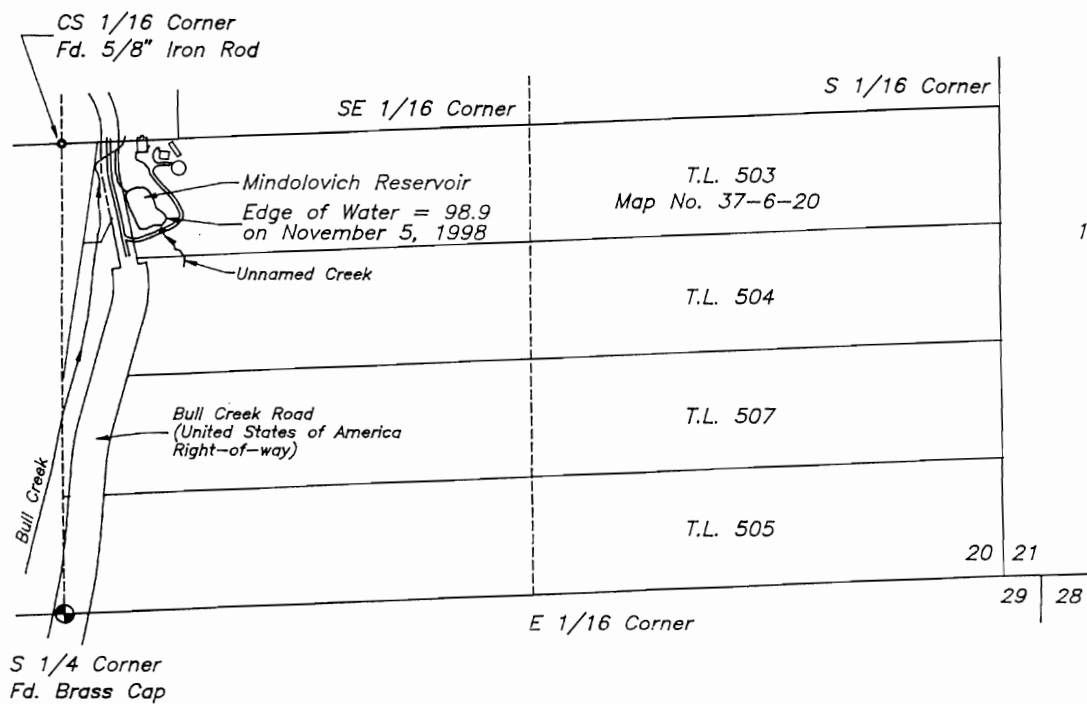

NOTE:

The measurements to determine the storage volume of this pond were made on November 5, 1998 when the water level was 98.9 feet. The calculated volume is therefore subject to any errors which may be disclosed if a subsequent survey is executed when the reservoir is empty.


The center of the dam is 1210 feet north and 175 feet east of the South Quarter Corner of Section 20. The center being the lowest point of the spillway crest.

These ties were computed from survey measurements made to monuments found per Survey No. 87-97.

This plat was prepared for the purpose of identifying the location of the water right only. There is no intent to provide dimensions or locations of property ownership lines.

Supporting Documents: Application No. R-72344, Permit No. R-11831.

PROJECT NO.
597-98-398
DRAWING NO.
58-11.17
DATE
11-13-98
SCALE
1" = 400'
SHEET
1 OF 2

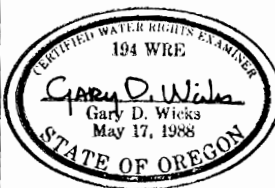

PLAT OF CLAIM OF BENEFICIAL USE

LOCATED IN

S1/2SE1/4 Section 20, T.37 S.,R.6 W.,W.M.
Josephine County, Oregon

PREPARED FOR:

Dan Mindolovich
1729 Bull Creek Road
Grants Pass, Oregon 97527
Tel. (541) 476-2681

PREPARED BY:

WICKS ENGINEERING & SURVEYING
311 N.E. "D" Street
Grants Pass, Oregon 97526
Tel. (541) 479-3436

WATER RESOURCES DEPT.
SALEM, OREGON

NOV 30 1998

RECEIVED