


RECEIVED

SEP 22 1989

WATER RESOURCES DEPT.
SALEM, OREGON

T.9 S. R.1 E., W.M.

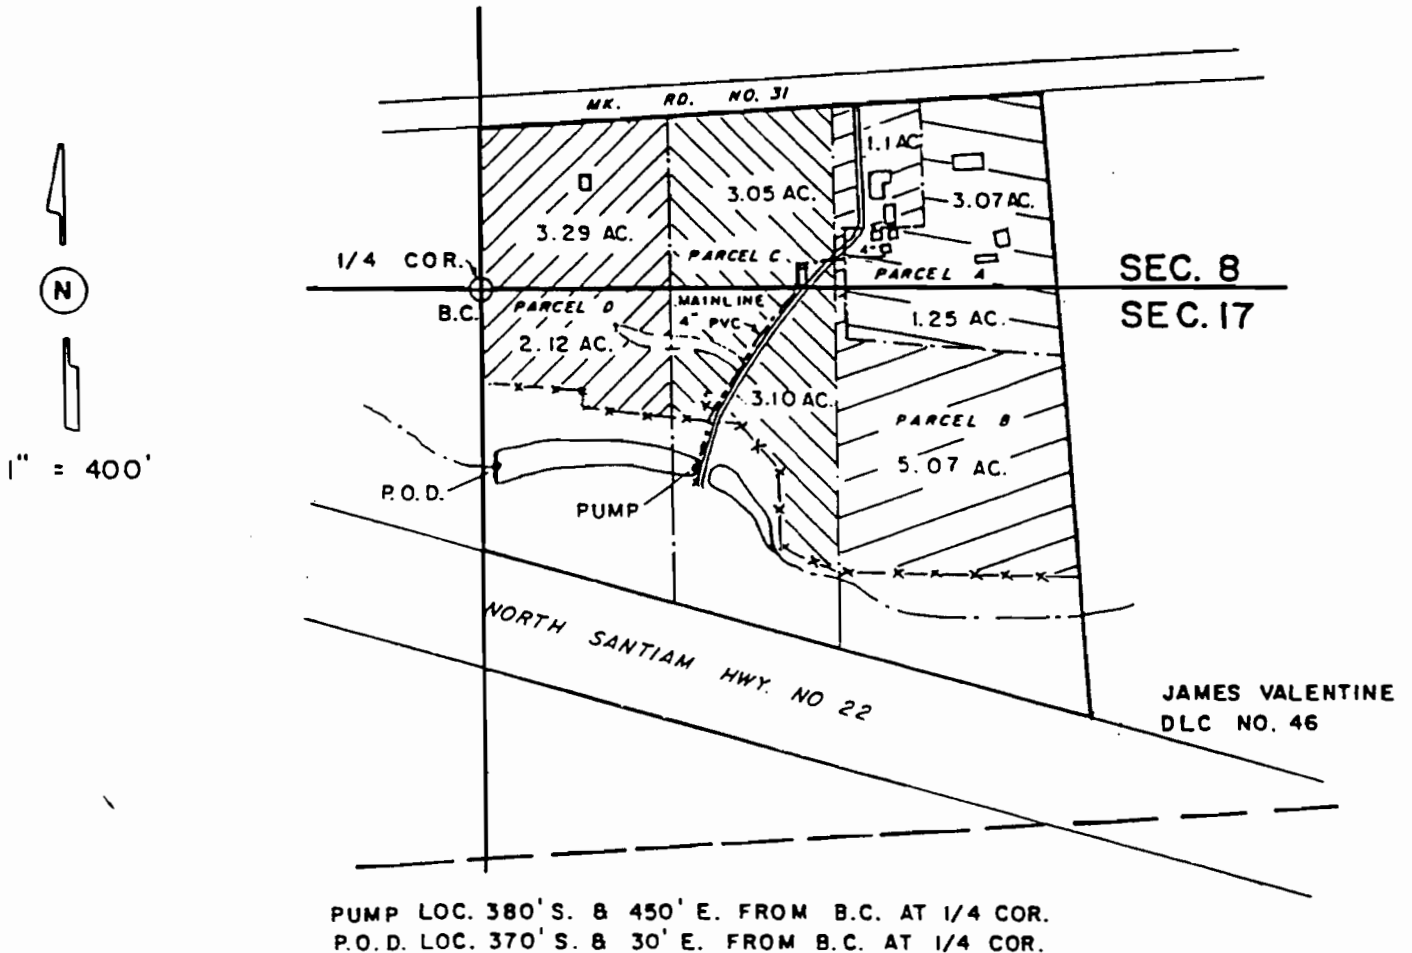

FINAL PROOF SURVEY
UNDER

R-72886


R-11600

Application No. ~~72886~~ Permt No. ~~51834~~

IN NAME OF

CECELIA R. FERY

Surveyed Sept. 9, 1992, by ...
Inspected Aug. 10, 1999

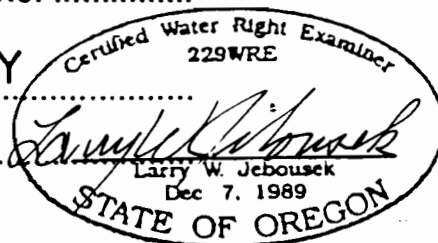

THIS MAP WAS PREPARED FOR THE PURPOSE OF IDENTIFYING THE LOCATION OF A WATER RIGHT ONLY AND IS NOT INTENDED TO PROVIDE LEGAL DIMENSIONS OR LOCATION OF PROPERTY OWNERSHIP LINES.