



# T.9 S., R.1W., W.M.

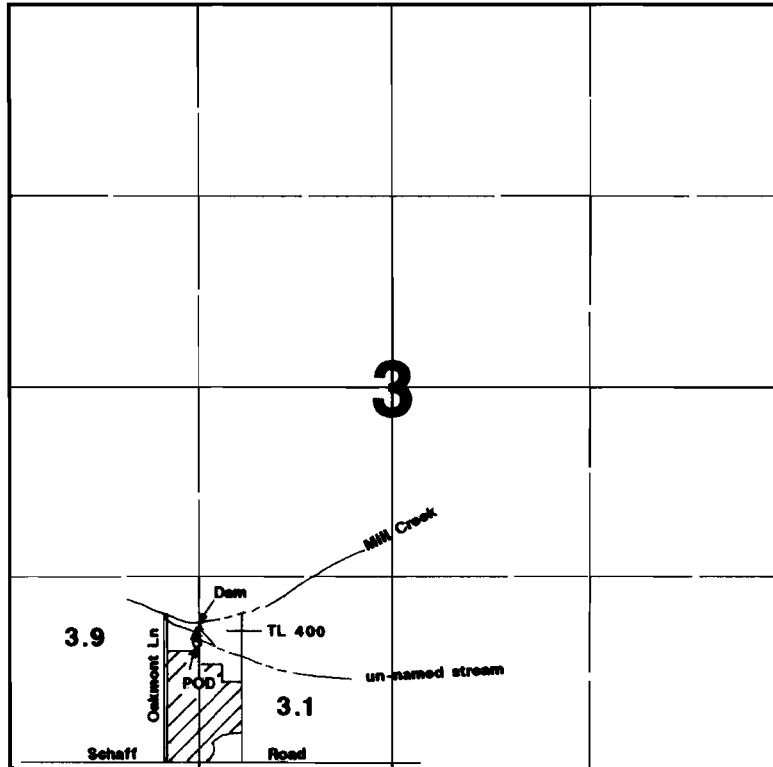

1" = 1320'

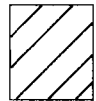

Area Irrigated

Dam & POD are located 870'N & 1290' E from the SW corner of Section 3.

**RECEIVED**

**AUG 03 2005**

**WATER RESOURCES DEPT  
SALEM, OREGON**

## Final Proof Survey

In the Name of

# Don Harteloo

**Application #: R-84320      Permit #: R-13084**  
**Application #: S-84321      Permit #: 53750**

Surveyed on September 1, 2004 by JM Schuette

This Map was Prepared for the Purpose of Identifying the Location of a Water Right Only and is Not Intended to Provide Legal Dimensions or Location of Property Ownership Lines.

