



T. 37 S., R. 32 1/2 E., W.M.

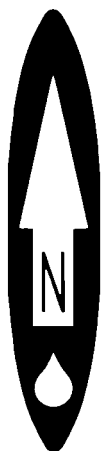

1" = 1320'

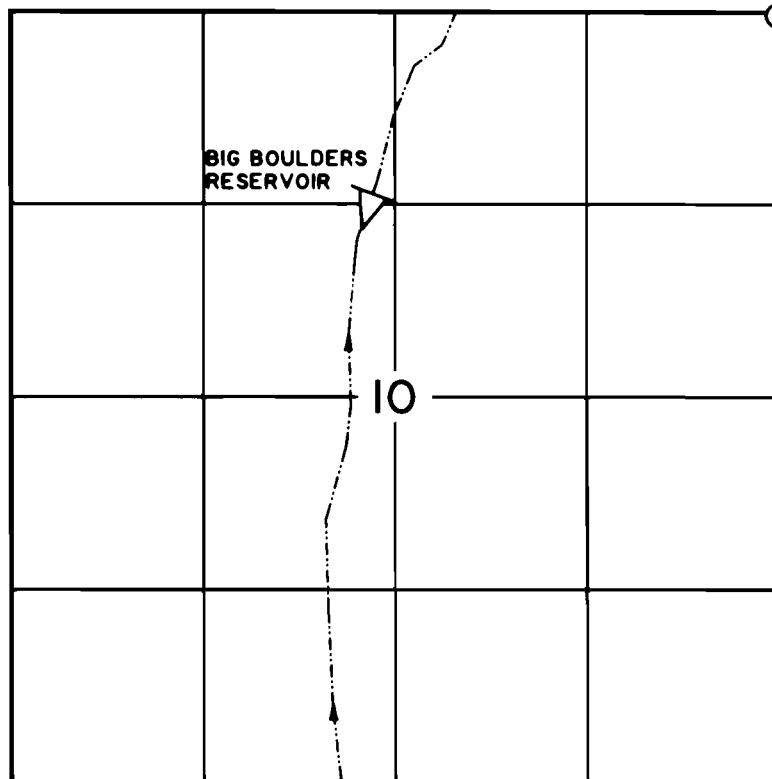

DIVERSION IS 1250
FEET SOUTH AND
2790 FEET WEST
OF THE NE CORNER
OF SECTION 10.

CLAIM OF BENEFICIAL USE MAP

IN NAME OF

UNITED STATES BUREAU OF LAND MANAGEMENT

APPLICATION NO. R-68522

PERMIT NO. R-III22


RECEIVED

OCT 02 2000

WATER RESOURCES DEPT.
SALEM, OREGON

SURVEYED: MAY 23, 2000

THE PURPOSE OF THIS MAP IS FOR IDENTIFYING THE LOCATION OF THE WATER RIGHT ONLY AND
IS NOT INTENDED TO PROVIDE LEGAL DIMENSIONS OR LOCATION OF PROPERTY OWNERSHIP LINES.

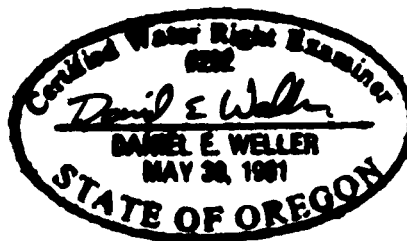

EXPIRES JUNE 30, 2002


BLM PROJECT NO. OR- 5416

U.S. BUREAU OF LAND MANAGEMENT-OSO
BRANCH OF CADASTRAL SURVEY
DWG: BIG BOULDERS

EXECUTED BY:
DANIEL E. WELLER; PLS, CWRE
P.O. BOX 2965
PORTLAND, OREGON 97208

T. 37 S., R. 32 1/2 E., W.M.

DIVERSION IS 2285
FEET SOUTH AND
1440 FEET EAST OF
THE NW CORNER OF
SECTION II.

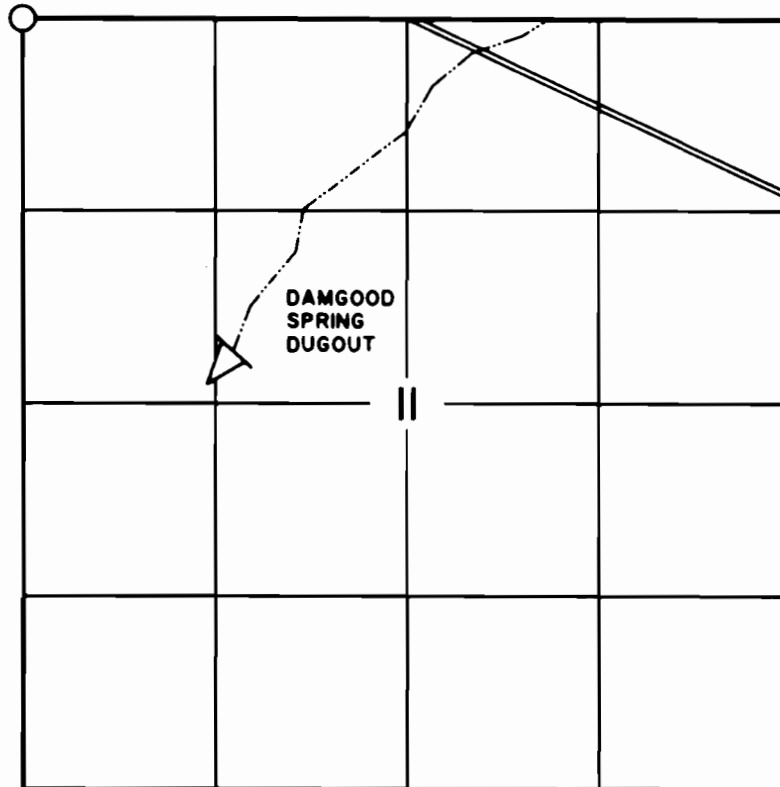

1" = 1320'

CLAIM OF BENEFICIAL USE MAP

IN NAME OF

UNITED STATES BUREAU OF LAND MANAGEMENT

APPLICATION NO. R-68522


PERMIT NO. R-III22

RECEIVED

OCT 02 2000

WATER RESOURCES DEPT.
SALEM, OREGON

SURVEYED: MAY 23, 2000

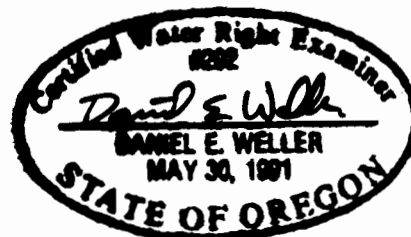

EXPIRES JUNE 30, 2002

THE PURPOSE OF THIS MAP IS FOR IDENTIFYING THE LOCATION OF THE WATER RIGHT ONLY AND
IS NOT INTENDED TO PROVIDE LEGAL DIMENSIONS OR LOCATION OF PROPERTY OWNERSHIP LINES.

BLM PROJECT NO. OR-5415

U.S. BUREAU OF LAND MANAGEMENT-OSO
BRANCH OF CADASTRAL SURVEY
DWG: DAMGOOD

EXECUTED BY:
DANIEL E. WELLER, PLS, CWRE
P.O. BOX 2965
PORTLAND, OREGON 97208