




CLAIM OF BENEFICIAL USE - 9/25/01
 Application No. R-72391 Permit No. R-12220
 Tax Lots 9 42 3100 & 10 42 800 - Baker County

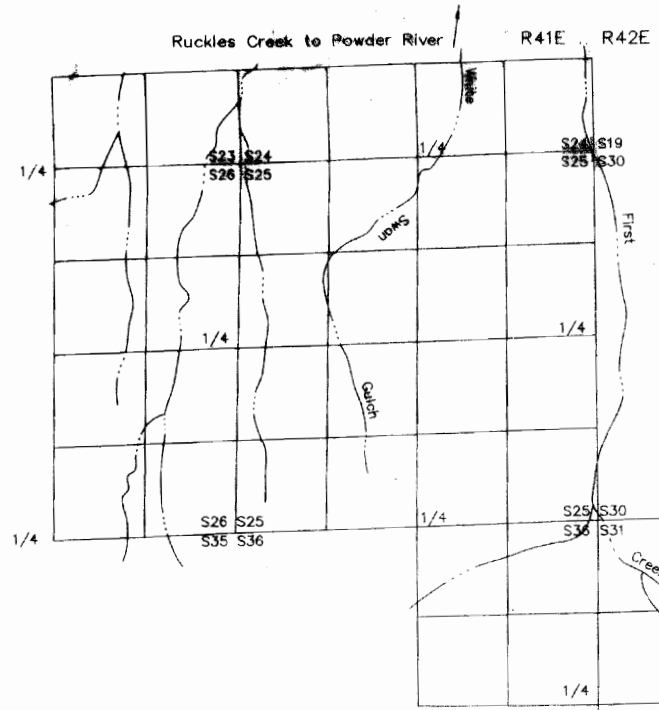


Scale 1" = 2,000'

For:
 Duncan S. MacKenzie &
 Elizabeth Harrell-MacKenzie
 19265 Chandler Lane
 Baker City, OR 97814



This map is for the purpose of identifying the location of the water right only and has no intent to provide dimensions or location of property ownership lines.

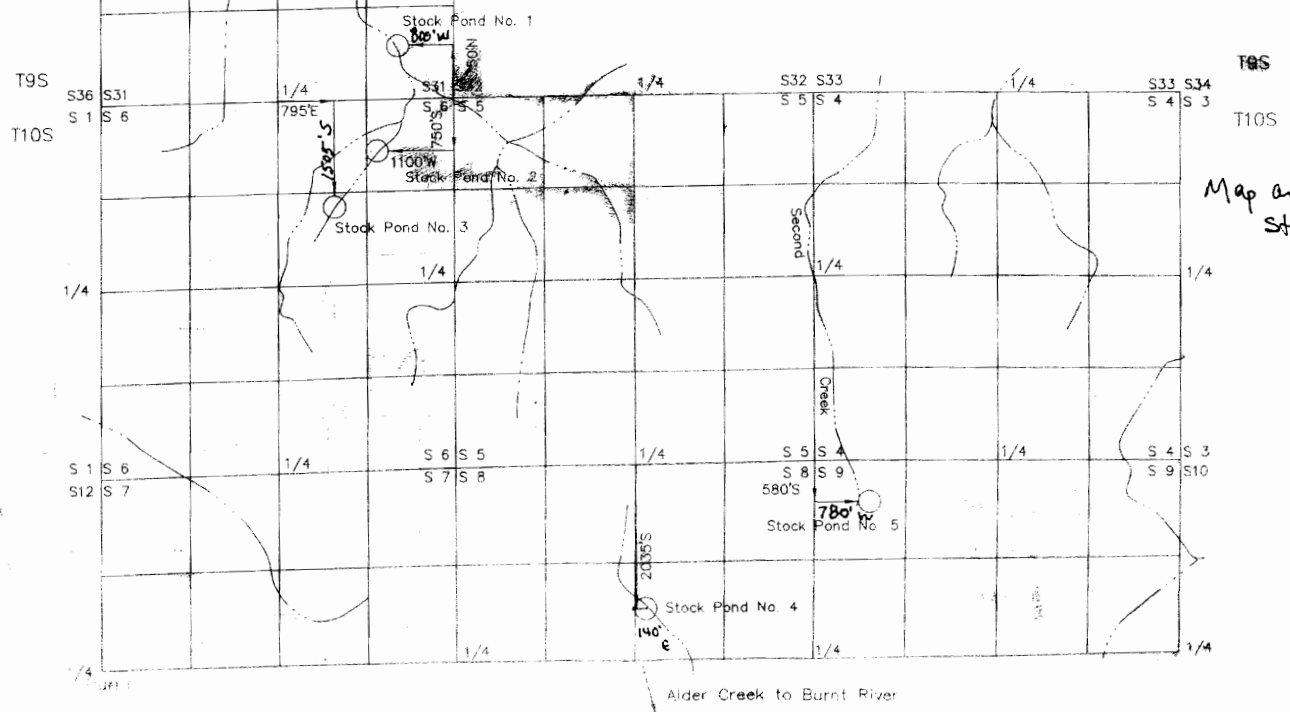

Map amended by wso
 Staff, 8-19-2003 jwg