


**RECEIVED**

DEC 29 1997


WATER RESOURCES DEPT.  
SALEM, OREGON

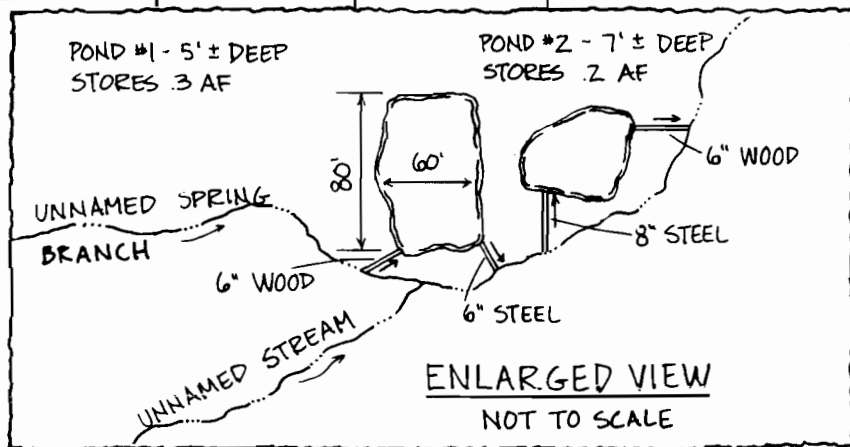

POD. FOR POND NO. 1 IS 1550'S, 100' W OF NE CORNER OF SEC 16 T2S R44E. POND NO. 1 IS WITHIN THE SE 1/4, NE 1/4 SEC 16.

POD. FOR POND NO. 2 IS 1500'S 50' E OF NW CORNER OF SEC 15, T2S R44E. POND NO. 2 IS WITHIN THE SW 1/4, NE 1/4, SEC 15.

UNNAMED STREAMS FEEDING PONDS ARE TRIBUTARIES OF THE WALLOWA RIVER, IN THE GRANDE RONDE BASIN.

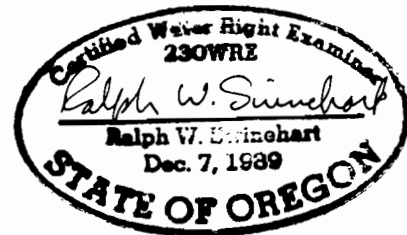

**FINAL PROOF MAP**  
**RESERVOIR PERMIT R-12124**  
IN SECTIONS 15 & 16, T2S, R44E, WM  
WALLOWA COUNTY  
FOR: GREG JOHNSON

DATE  
12/97  
JOB  
97837  
DESIGN  
RWS  
DRAWN  
TCB

WALLOWA MOUNTAIN  
ENGINEERING  
PO BOX 266  
ENTERPRISE, OREGON 97828  
426-4085

REVISIONS

SHEET  
1 OF  
1