


T. 41 S., R. 4 E., W.M.

DIVERSION IS 940 FEET SOUTH AND 1100 FEET WEST OF THE N 1/4 COR. OF SECTION 3.

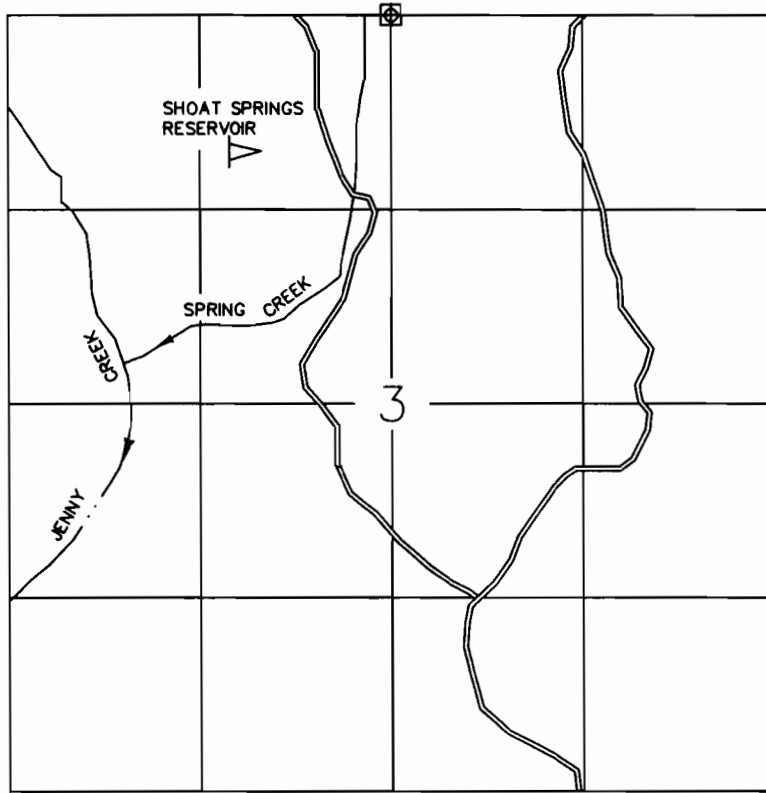

1" = 1320'

RECORDED
JUN 0 1 1999
PLS 12419

FINAL PROOF MAP
 IN NAME OF
 UNITED STATES BUREAU OF LAND MANAGEMENT

APPLICATION R- 83306

PERMIT R-12419



EXPIRES 6/30/00

SURVEYED: MAY 13, 1999

THE PURPOSE OF THIS MAP IS FOR IDENTIFYING THE LOCATION OF THE WATER RIGHT ONLY AND IS NOT INTENDED TO PROVIDE LEGAL DIMENSIONS OR LOCATION OF PROPERTY OWNERSHIP LINES.

U.S. BUREAU OF LAND MANAGEMENT-OSO
 BRANCH OF CADASTRAL SURVEY

DATED: DWG: SHOAT

EXECUTED BY:
 DANIEL E. WELLER, PLS, CWRE
 P.O. BOX 2965
 PORTLAND, OREGON 97208