


T.3 S. R.7 E. W.M.

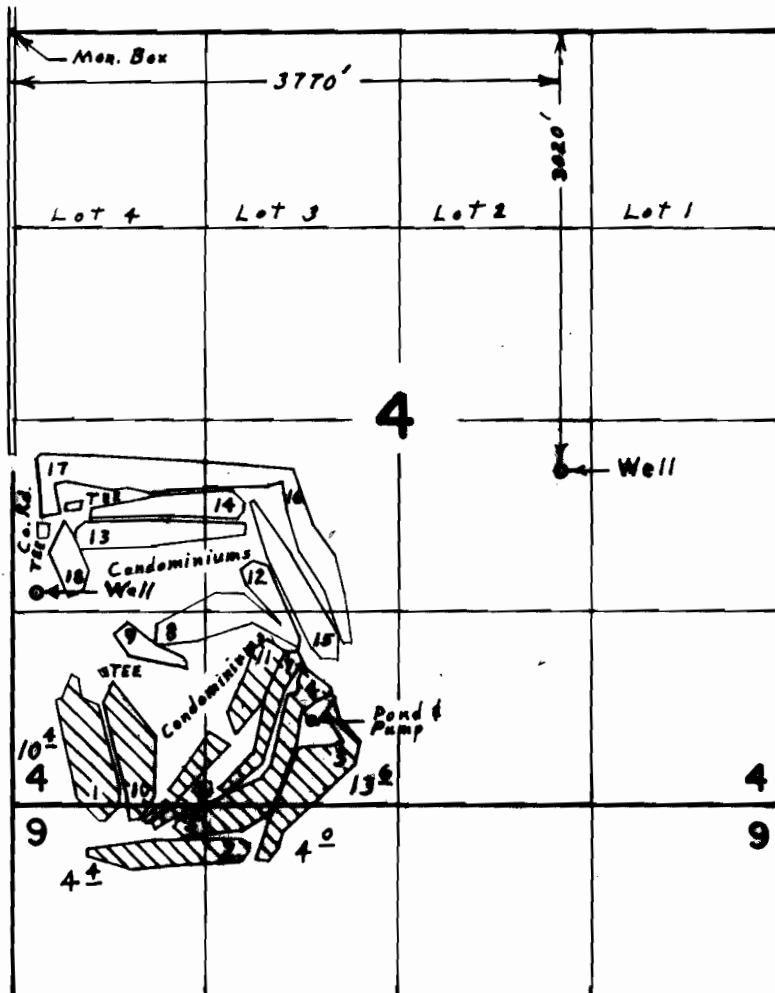

FINAL PROOF SURVEY UNDER

Application No. ~~0-3952~~ Permit No. ~~0-3713~~
IN NAME OF

SALMON VALLEY WATER COMPANY

Surveyed Oct. 12., 1976, by L. E. Gould.