



T. 5 S., R. 2 W., W. M.

N

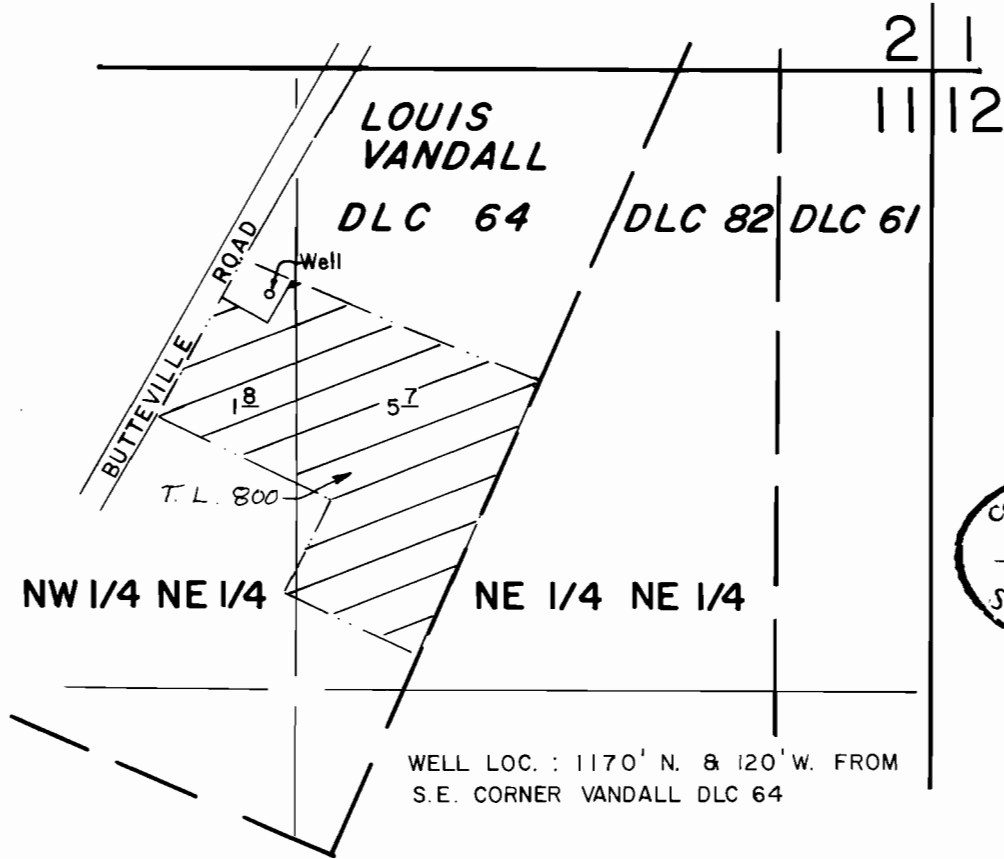

SCALE: 1" = 400'

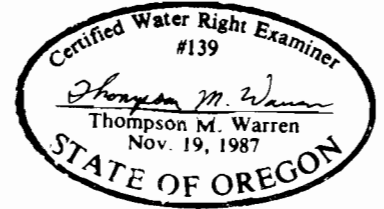

WELL LOC. : 1170' N. & 120' W. FROM S.E. CORNER VANDALL DLC 64

THIS MAP WAS PREPARED SOLELY FOR THE PURPOSE OF DEPICTING THE LOCATION OF A WATER RIGHT, AND HAS NO INTENTION OF BEING USED TO DETERMINE REAL PROPERTY BOUNDARIES.

FINAL PROOF SURVEY
under

A# G-13083 P# G-11840

in name of

HAROLD M. MILLER

Surveyed 9/30/95

RECEIVED

NOV 24 1995

WATER RESOURCES DEPT.
SALFORD DIVISION

ASCS PHOTO
41047-789-148 L