


T.35 S., R.2 W., W.M.

RECEIVED

NOV 12 1987  
LAND DIVISION DEPT  
AGRIC. OREGON

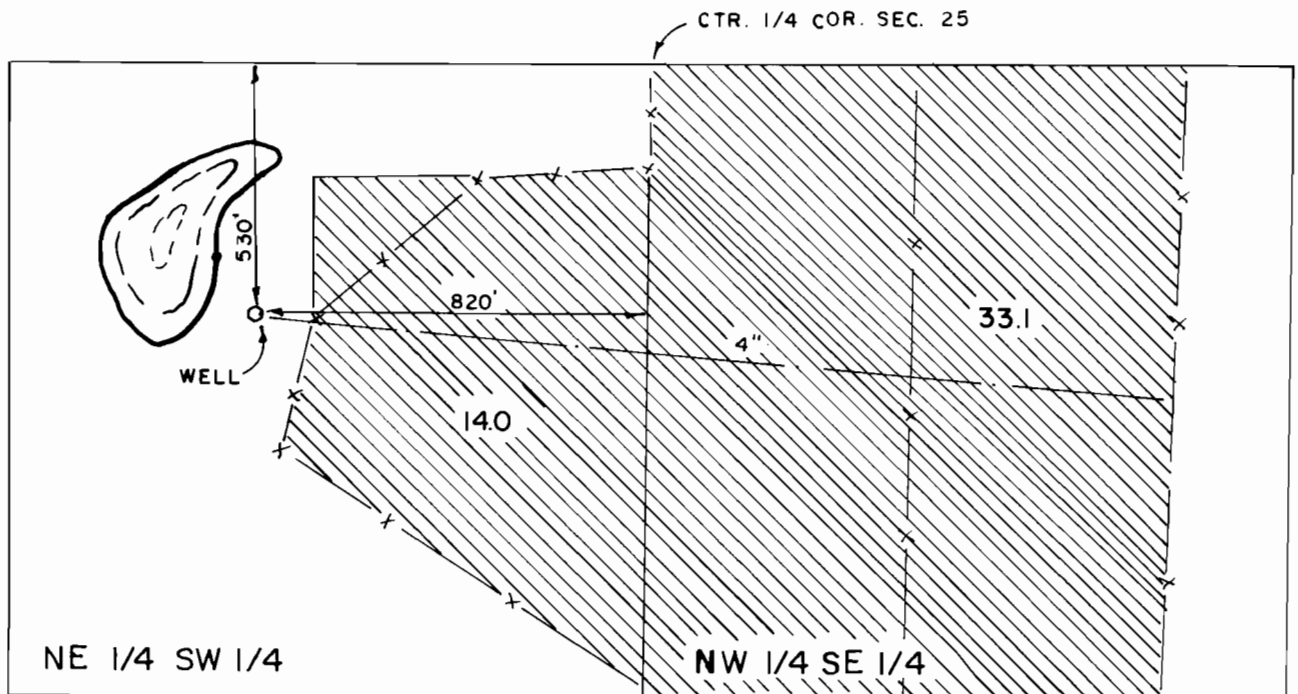

**FINAL PROOF MAP**

APPLICATION No. G-12058

PERMIT No. G-11225

IN THE NAME OF  
RICHARD COLLMAN

MAP PREPARED SEPTEMBER 29, 1995  
BY GARY D. KAISER

NOTE: MAP PREPARED FOR WATER  
RIGHT PURPOSES ONLY, NOT FOR  
PROPERTY BOUNDARY LOCATIONS.

SCALE: 1" = 400'

