


T. 39 S., R. 14 W., W. M.

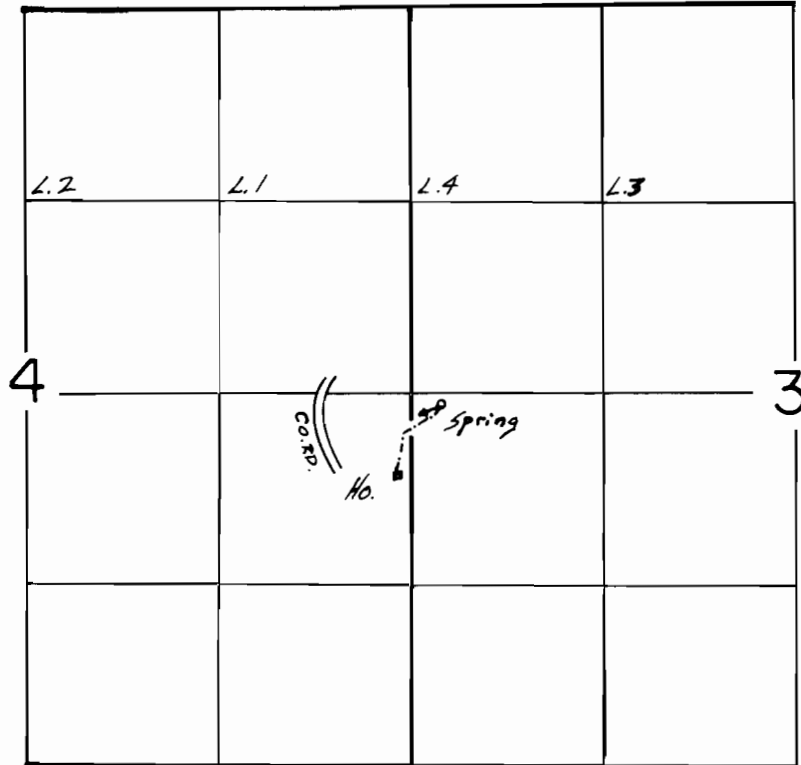

Spring: 50' S & 200' E from W/4 COR. SEC. 3.

Scale 1" = 1320'

FINAL PROOF SURVEY UNDER

Application No. 56815. Permit No. 42735....
IN NAME OF

JACQUELINE PALMER.....

Surveyed June 24, 1996, by S. DeHaas.....