


TOWNSHIP 6 SOUTH, RANGE 2 WEST, W.M.

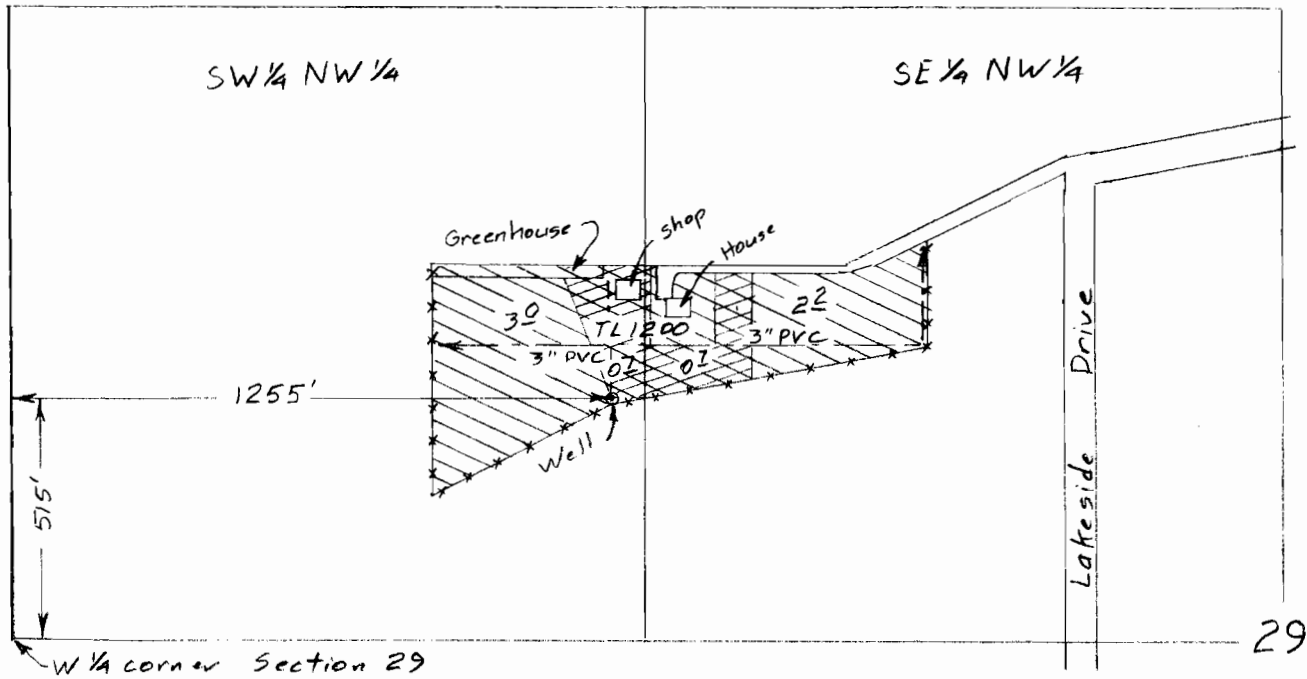


Scale 1" = 400'

Surveyed Dec 10, 2001

- ⊗ Container Area 1³/₄ acres
- ⊖ Nursery Area 6⁶/₁₀ acres

Claim of Beneficial Use Map
for
Paul Black & Thomas Johnson

Application G-14712
Permit G-13583

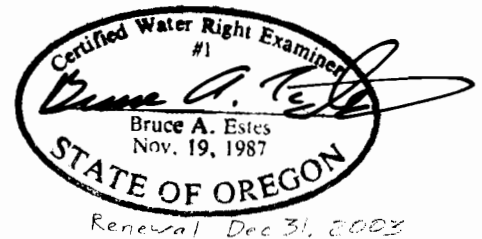

This map is for the purpose of locating a water right only and has no intent to provide legal dimensions or the location of property lines.

ESTES SURVEYS
 PO Box 17519 60382 Arnold Rd
 Salem, OR 97305-7519 Bend, OR 97702
 (503) 585-7593 (541) 382-7391