


T. 32 S., R. 36 E., W.M.

RECEIVED

NOV 12 1991

WATER RESOURCES DEPT  
SALEM, OREGON

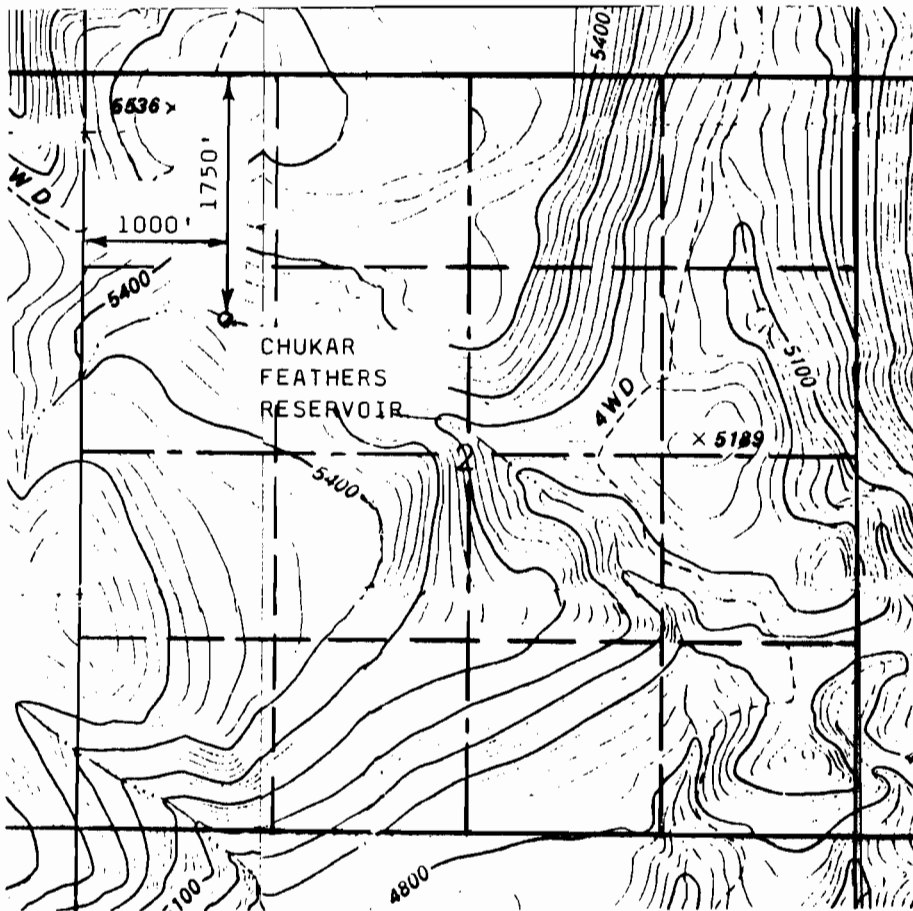

SCALE 1"=1320'

THE PURPOSE OF THIS MAP IS TO IDENTIFY THE LOCATION OF THE WATER RIGHT ONLY AND IS NOT INTENDED TO PROVIDE LEGAL DIMENSIONS OR LOCATIONS OF PROPERTY OWNERSHIP LINES

## FINAL PROOF SURVEY UNDER

Application No. R-69378 Permit No. R-11114

IN NAME OF

U.S. BUREAU OF LAND MANAGEMENT

BURNS DISTRICT

SURVEYED June 13, 1991

