
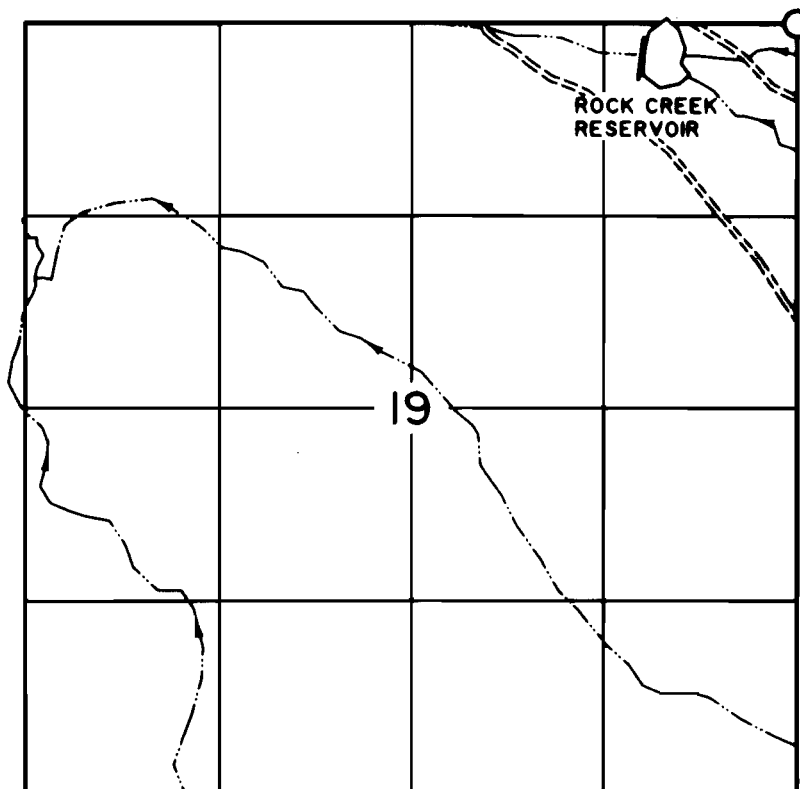


T. 29 S., R. 34 E., W.M.

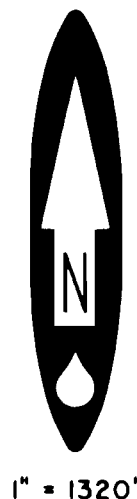

DIVERSION IS 195
FEET SOUTH AND
1060 FEET WEST
OF THE NE CORNER
OF SECTION 19.

CLAIM OF BENEFICIAL USE MAP

IN NAME OF


UNITED STATES BUREAU OF LAND MANAGEMENT

APPLICATION NO. R-69362

PERMIT NO. R-III27

RECEIVED

OCT 02 2000

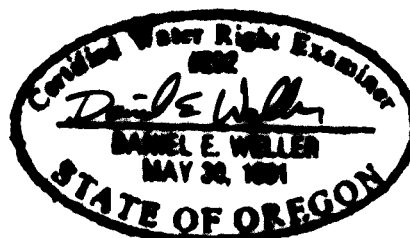

EXPIRES: JUNE 30, 2002

WATER RESOURCES DEPT.
SALEM, OREGON

SURVEYED: SEPTEMBER 5, 2000

THE PURPOSE OF THIS MAP IS FOR IDENTIFYING THE LOCATION OF THE WATER RIGHT ONLY AND
IS NOT INTENDED TO PROVIDE LEGAL DIMENSIONS OR LOCATION OF PROPERTY OWNERSHIP LINES.

BLM PROJECT NO. OR-5365

U.S. BUREAU OF LAND MANAGEMENT-OSO
BRANCH OF CADASTRAL SURVEY
DWG: ROCKCREK

EXECUTED BY:
DANIEL E. WELLER, PLS, CWRE
P.O. BOX 2965
PORTLAND, OREGON 97208