


T. 32 S., R. 36 E., W.M.

DIVERSION IS 760
FEET SOUTH AND
1550 FEET EAST
OF THE NW CORNER
OF SECTION 3.



DIVERSION IS 900
FEET SOUTH AND
2100 FEET WEST
OF THE NE CORNER
OF SECTION 3.

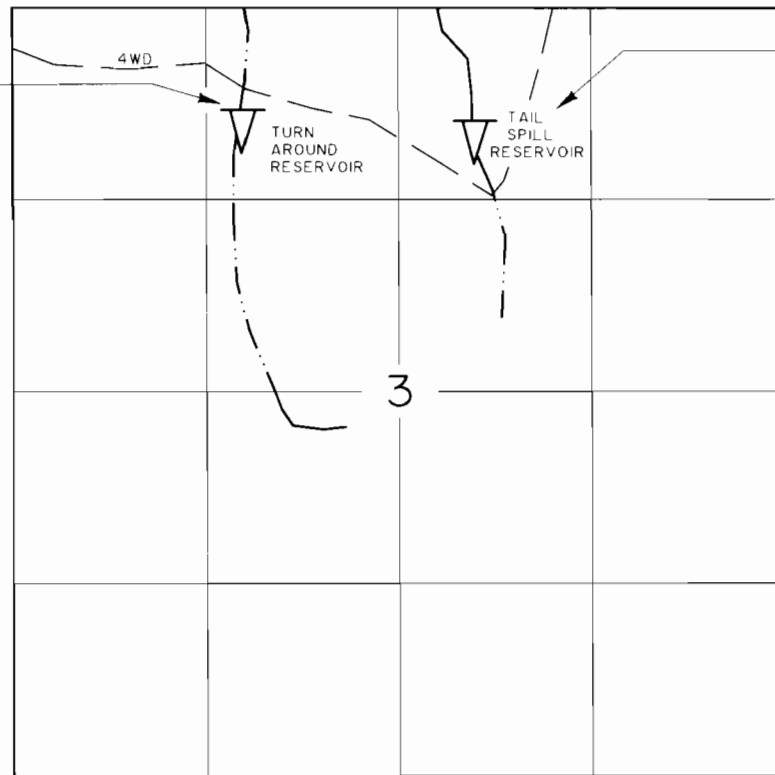

1" = 1320'
RECEIVED


CLAIM OF BENEFICIAL USE MAP

IN NAME OF

UNITED STATES BUREAU OF LAND MANAGEMENT

APPLICATION NO. R-69340

PERMIT NO. R-II747

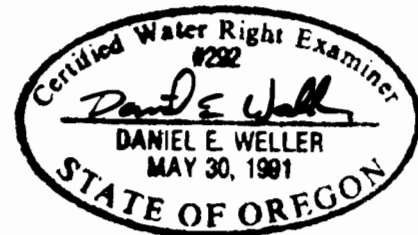

EXPIRES 6/30/00

SURVEYED: JUNE 30, 1999

THE PURPOSE OF THIS MAP IS FOR IDENTIFYING THE LOCATION OF THE WATER RIGHT ONLY AND
IS NOT INTENDED TO PROVIDE LEGAL DIMENSIONS OR LOCATION OF PROPERTY OWNERSHIP LINES

U.S. BUREAU OF LAND MANAGEMENT-OSO
BRANCH OF GEOGRAPHIC SCIENCES


DWG: TAIL

EXECUTED BY:
DANIEL E. WELLER, PLS, CWRE
P.O. BOX 2965
PORTLAND, OREGON 97208

T. 31 S., R. 36 E., W.M.

RECEIVED

JUN 30 1999

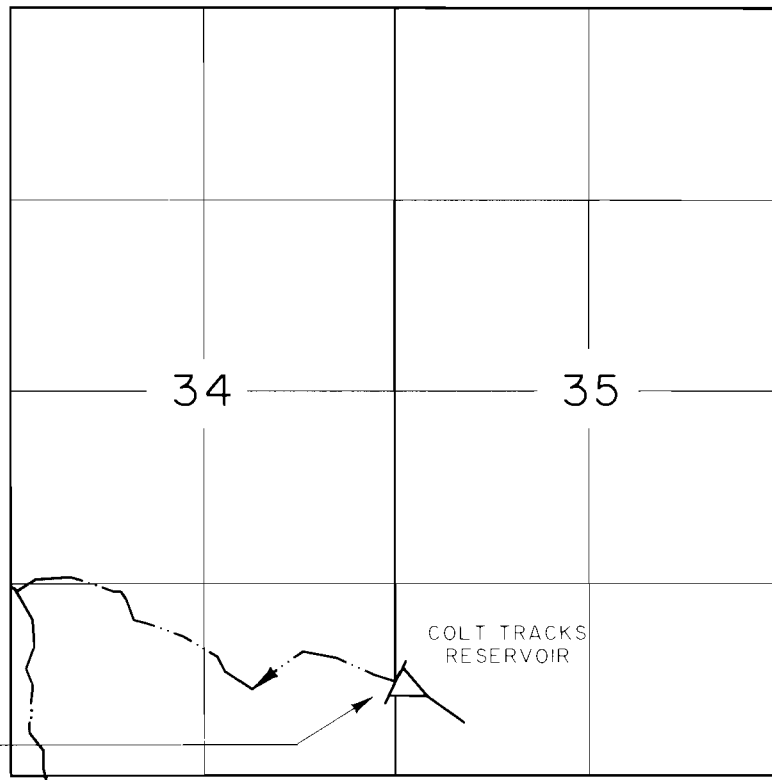WATER RESOURCES DEPT.
SALEM, OREGON

DIVERSION IS 800
FEET NORTH AND
ON SECTION LINE
FROM THE SW COR.
OF SECTION 35.



1" = 1320'


CLAIM OF BENEFICIAL USE MAP

IN NAME OF

UNITED STATES BUREAU OF LAND MANAGEMENT

APPLICATION NO. R-69340

PERMIT NO. R-11747

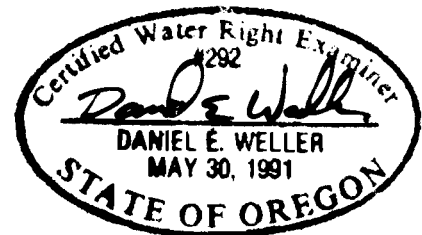

EXPIRES 6/30/00

SURVEYED: JUNE 30, 1999

THE PURPOSE OF THIS MAP IS FOR IDENTIFYING THE LOCATION OF THE WATER RIGHT ONLY AND
IS NOT INTENDED TO PROVIDE LEGAL DIMENSIONS OR LOCATION OF PROPERTY OWNERSHIP LINES

U.S. BUREAU OF LAND MANAGEMENT-OSO
BRANCH OF GEOGRAPHIC SCIENCES

DWG: COLT

EXECUTED BY:
DANIEL E. WELLER, PLS, CWRE
P.O. BOX 2965
PORTLAND, OREGON 97208