


T. 40S., R. 4 W., W.M.

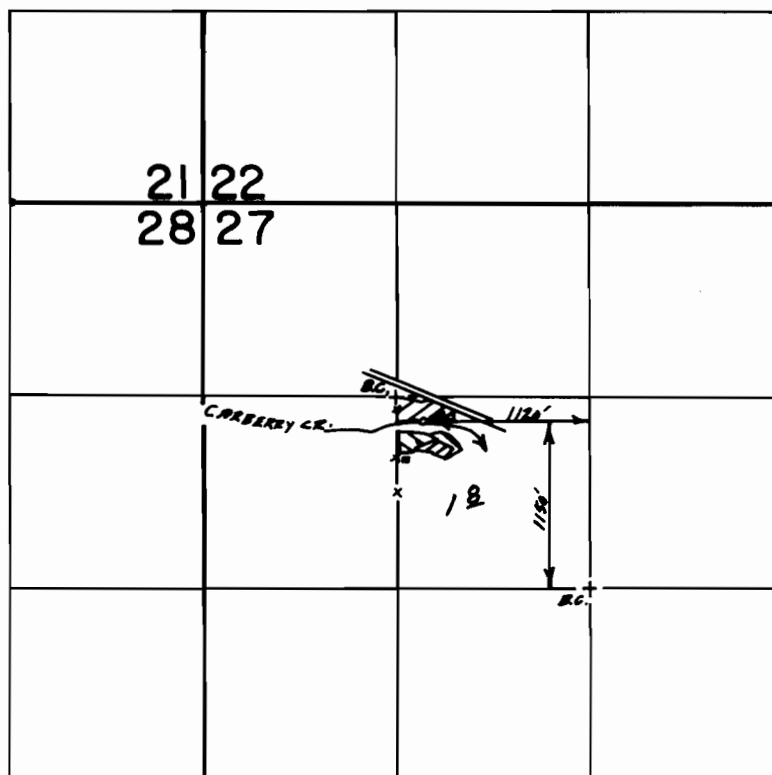

RECEIVED

MAY 10 1996
WATER RESOURCES DEPT.
SALEM, OREGON

Scale 1" = 1320'

- ☒ Suppl. 1.8 acres
- ☒ Primary 0.8 acre (carberry creek)
& Suppl.

FINAL PROOF SURVEY UNDER

Application No. 62130. Permit No. 46622...
IN NAME OF

JAY & JANICE COOPER.....

Surveyed April 17, 1996, by S. DeHaas.....