


**T2S & T3S, R24E, W.M.,
MORROW COUNTY, OREGON
FINAL PROOF SURVEY**

Application No. G-11766
Permit No. G-11235

IN THE NAME OF:

JAMES A. WEST
Rt. 1, Box 37
Ione, Oregon 97843


*This map is for identifying the location of
water rights only and is not intended to show
property lines or dimensions.*

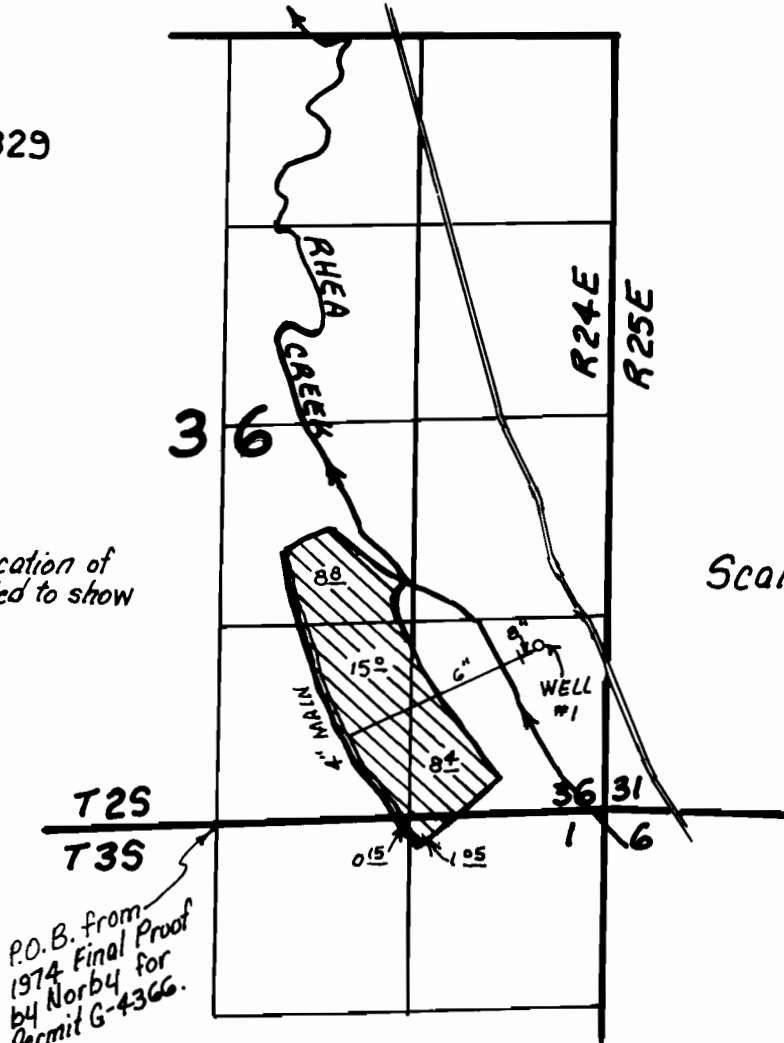

Scale: 1" = 1320'

Survey Subd

Well #1 lies 1210' North & 2180' East
of the S 1/4 of Section 36 from 1974
Final Proof Survey by Norby for Permit
#G-4366.

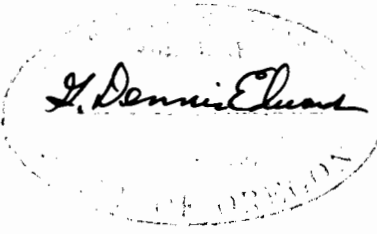

RECEIVED

WATER RESOURCES DEPT.
SALEM, OREGON

Edwards Surveying P.O. Box 763
503-567-3336 Hermiston, OR. 97838
9/28/95 Job #W8803011-A