


T.4 S. R.2 W. W.M.

NOV 17 1995
DEC 7 1989

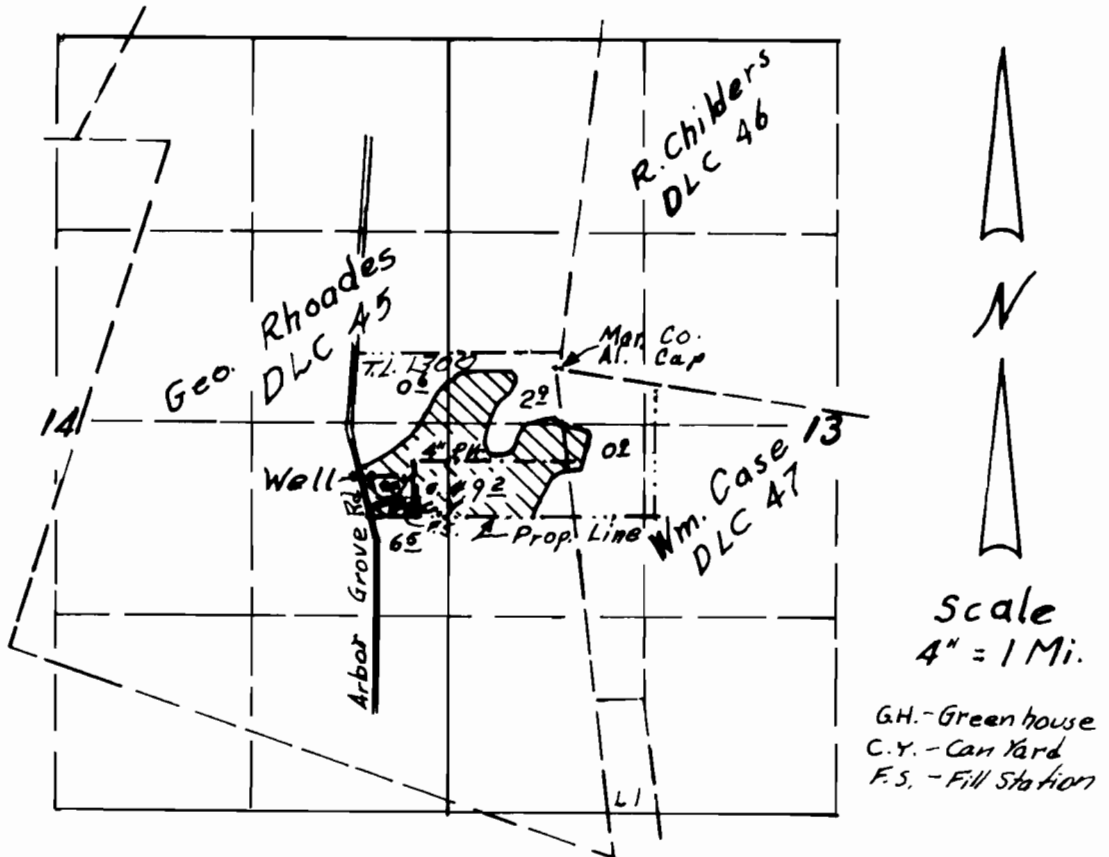

Well loc. 720' S & 1320' W from SW Cor DLC 46

FINAL PROOF SURVEY UNDER Appl. No. G-12435 Permit No. G-11427 For STEVE CATTS

THIS MAP WAS PREPARED FOR THE PURPOSE OF IDENTIFYING THE LOCATION OF A WATER RIGHT ONLY AND IS NOT INTENDED TO PROVIDE LEGAL DIMENSIONS OR LOCATION OF PROPERTY OWNERSHIP LINES.

