


T2S R2W WM

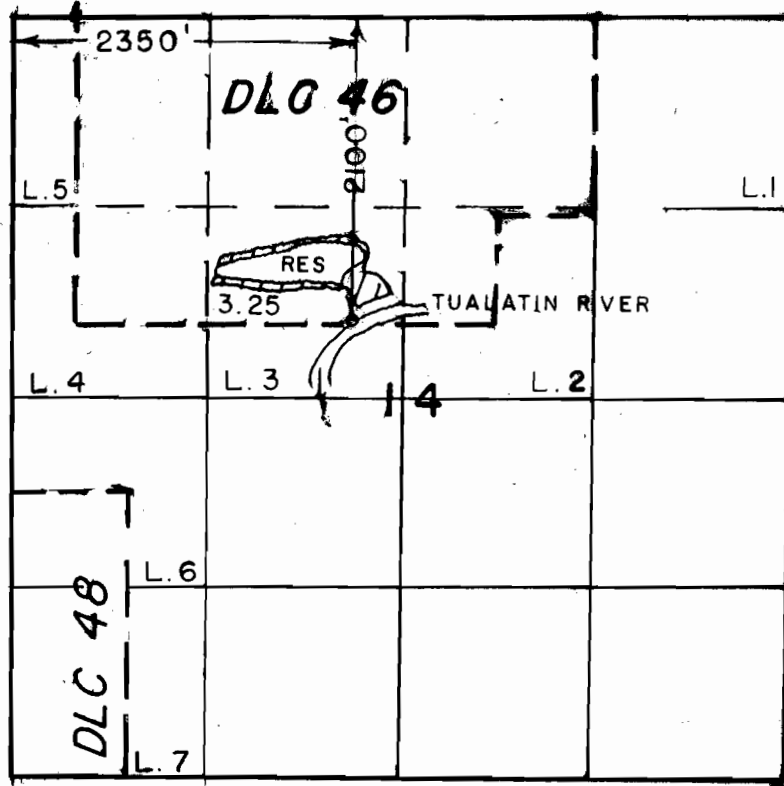

**FINAL PROOF SURVEY**  
**UNDER**

R-64055      R-8507  
Application No. ~~64051~~ Permit No. 47067

**IN NAME OF**

**DONALD W NEAL**

Surveyed JUL 8, 1988, by T. WARREN