


T2S R2W WM

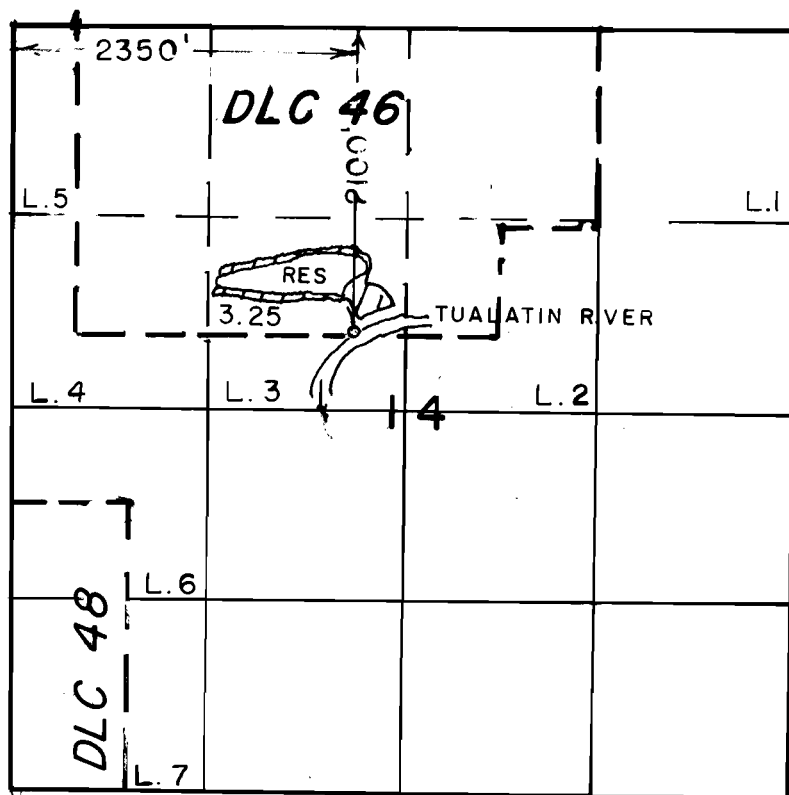

FINAL PROOF SURVEY
UNDER

R-64055 R-8507
Application No. **64051** Permit No. **47067**
IN NAME OF

DONALD W NEAL

Surveyed JUL 8, 1988, by T. WARREN