


T. 23S., R. 12W., W. M.

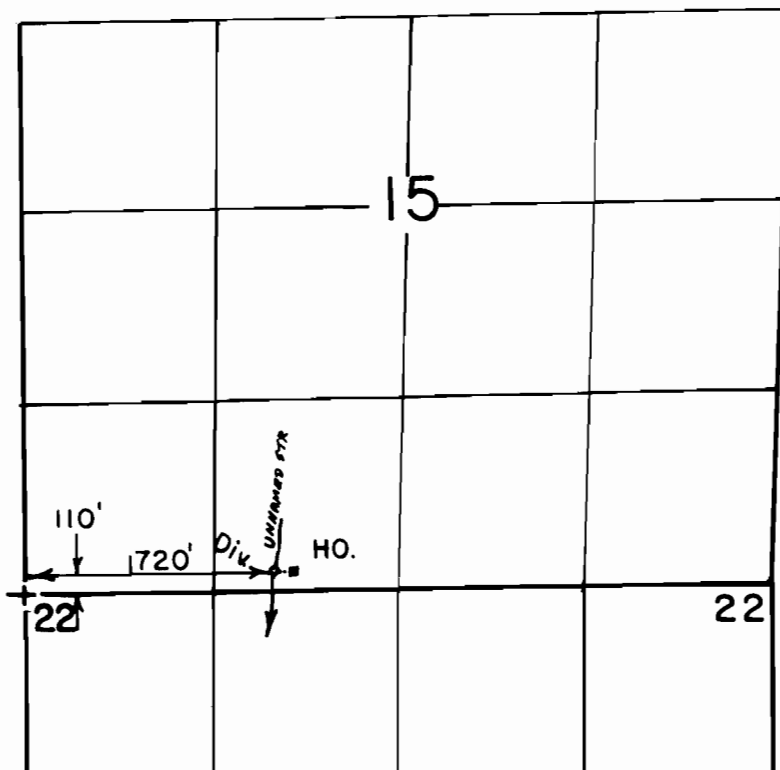

Scale 1" = 1320'

FINAL PROOF SURVEY

UNDER

Application No. 58828 Permit No. 44448..
IN NAME OF

Surveyed May 14, 1997, by S. DeHaas.....

MAY 19 1967
NATURAL RESOURCES DEPT
SALEM, OREGON

4101-180-244B

had
5/97