
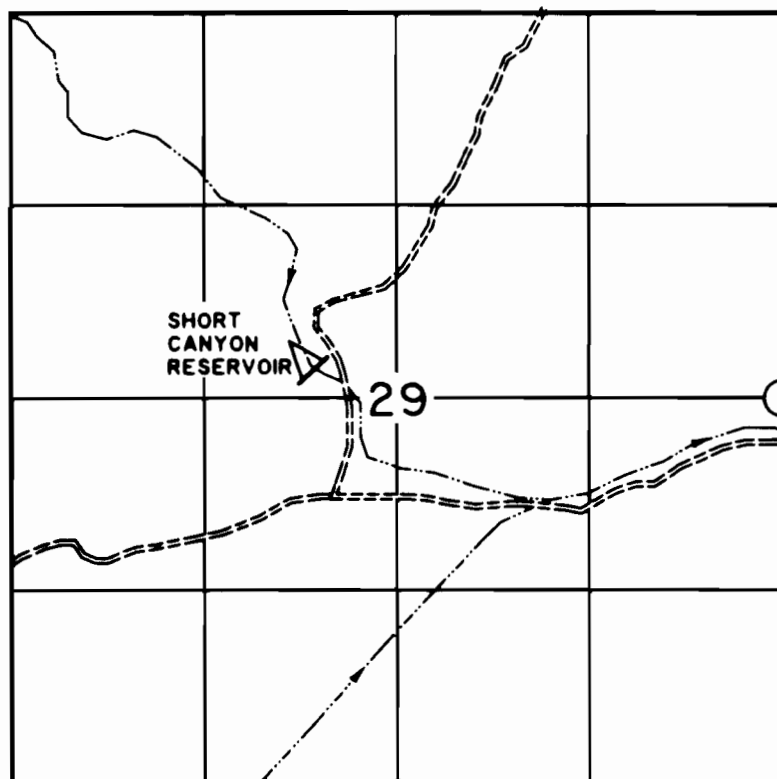


T. 34 S., R. 36 E., W.M.

SHEET 1 OF 4

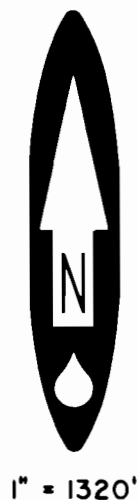

DIVERSION IS 190 FEET
NORTH AND 3250 FEET
WEST OF THE EAST 1/4
CORNER OF SECTION 29.

CLAIM OF BENEFICIAL USE MAP

IN NAME OF

UNITED STATES BUREAU OF LAND MANAGEMENT

APPLICATION NO. R-68503

PERMIT NO. R-III19

RECEIVED

OCT 02 2000

WATER RESOURCES DEPT.
SALEM, OREGON

SURVEYED: AUGUST 29, 2000

THE PURPOSE OF THIS MAP IS FOR IDENTIFYING THE LOCATION OF THE WATER RIGHT ONLY AND
IS NOT INTENDED TO PROVIDE LEGAL DIMENSIONS OR LOCATION OF PROPERTY OWNERSHIP LINES.



EXPIRES: JUNE 30, 2002

BLM PROJECT NO. OR-10-5437


U.S. BUREAU OF LAND MANAGEMENT-OSO
BRANCH OF CADASTRAL SURVEY
DWG: SHORT

EXECUTED BY:
DANIEL E. WELLER, PLS, CWRE
P.O. BOX 2965
PORTLAND, OREGON 97208

T. 34 S., R. 36 E., W.M.

DIVERSION OF PAUL
RESERVOIR IS 2135
FEET SOUTH AND 160
FEET EAST OF THE
NW CORNER OF
SECTION 27.

DIVERSION OF MIKE
RESERVOIR IS 2835
FEET SOUTH AND
3005 FEET EAST OF
THE NW CORNER OF
SECTION 27.

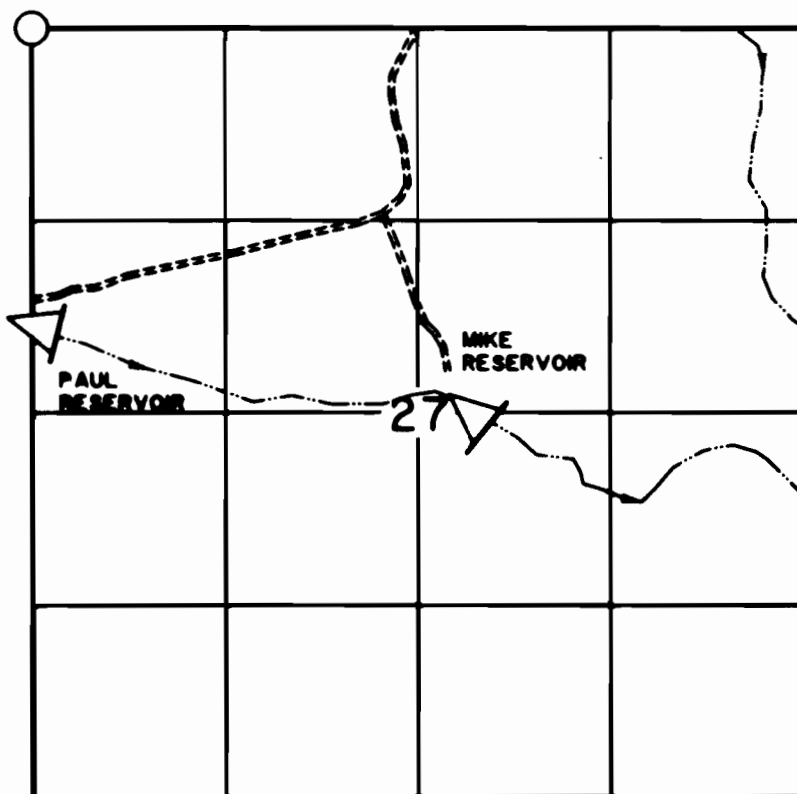

1" = 1320'

CLAIM OF BENEFICIAL USE MAP

IN NAME OF


UNITED STATES BUREAU OF LAND MANAGEMENT

APPLICATION NO. R-68503

PERMIT NO. R-11119

RECEIVED

OCT 02 2000

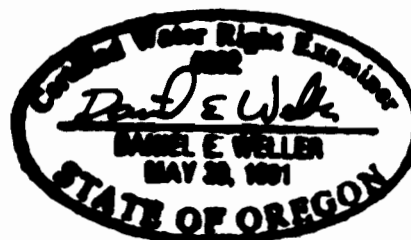

EXPIRES: JUNE 30, 2002

WATER RESOURCES DEPT.
SALEM, OREGON

SURVEYED: AUGUST 29, 2000


THE PURPOSE OF THIS MAP IS FOR IDENTIFYING THE LOCATION OF THE WATER RIGHT ONLY AND
IS NOT INTENDED TO PROVIDE LEGAL DIMENSIONS OR LOCATION OF PROPERTY OWNERSHIP LINES.

BLM PROJECT NO. OR-10-5431,5432

U.S. BUREAU OF LAND MANAGEMENT-OSO
BRANCH OF CADASTRAL SURVEY
DWG: PAUL

EXECUTED BY:
DANIEL E. WELLER, PLS, CWRE
P.O. BOX 2965
PORTLAND, OREGON 97208

T. 34 S., R. 36 E., W.M.

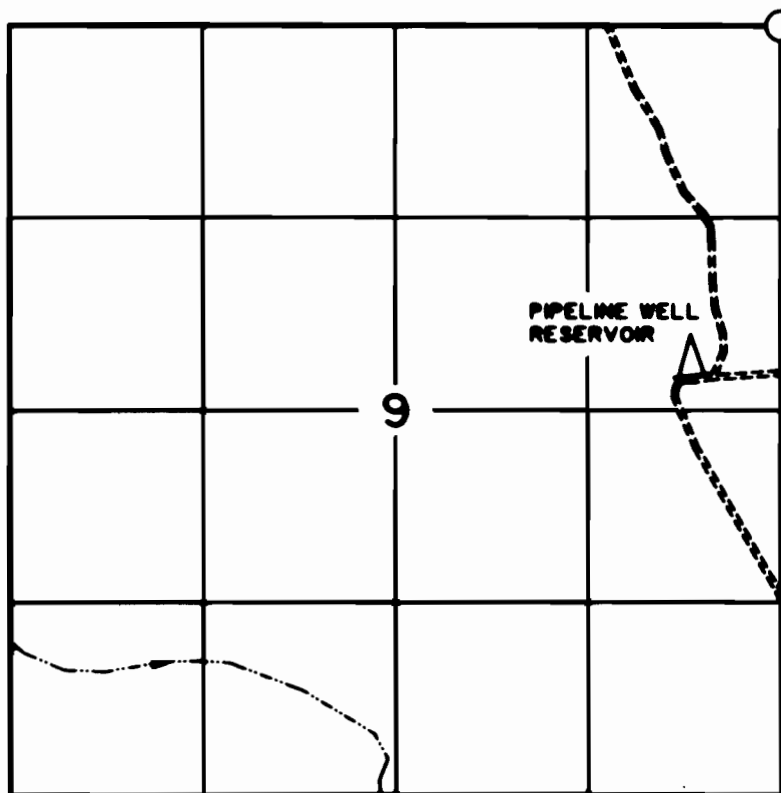

DIVERSION IS 2530
FEET SOUTH AND
615 FEET WEST OF
THE NE CORNER OF
SECTION 9.

PIPELINE WELL
RESERVOIR

CLAIM OF BENEFICIAL USE MAP

IN NAME OF


UNITED STATES BUREAU OF LAND MANAGEMENT

APPLICATION NO. R-68503

PERMIT NO. R-11119

RECEIVED

OCT 02 2000

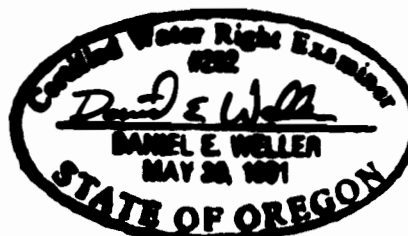

EXPIRES: JUNE 30, 2002

WATER RESOURCES DEPT.
SALEM, OREGON

SURVEYED: AUGUST 29, 2000



THE PURPOSE OF THIS MAP IS FOR IDENTIFYING THE LOCATION OF THE WATER RIGHT ONLY AND
IS NOT INTENDED TO PROVIDE LEGAL DIMENSIONS OR LOCATION OF PROPERTY OWNERSHIP LINES.

BLM PROJECT NO. OR-10-5430

U.S. BUREAU OF LAND MANAGEMENT-OSO
BRANCH OF CADASTRAL SURVEY
DWG: PIPELINE

EXECUTED BY:
DANIEL E. WELLER, PLS, CWRE
P.O. BOX 2965
PORTLAND, OREGON 97208

T. 34 S., R. 36 E., W.M.

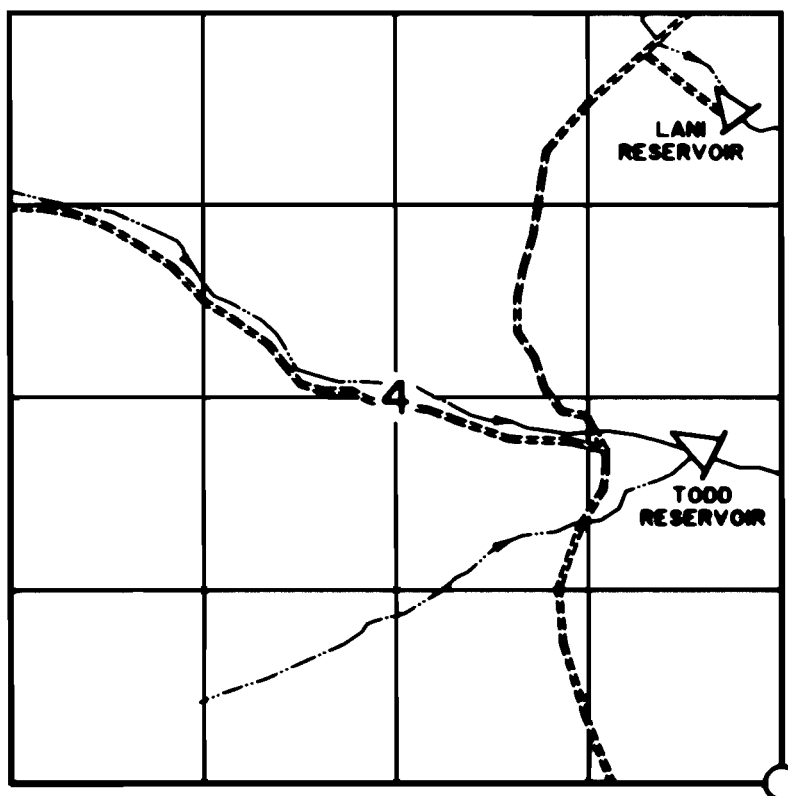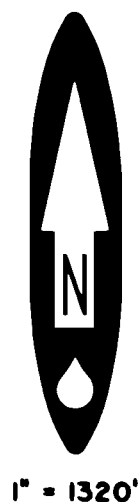

DIVERSION OF LANI
RESERVOIR IS 4545
FEET NORTH AND
280 FEET WEST OF
THE SE CORNER OF
SECTION 4.

DIVERSION OF TODD
RESERVOIR IS 2220
FEET NORTH AND
480 FEET WEST OF
THE SE CORNER OF
SECTION 4.


CLAIM OF BENEFICIAL USE MAP

IN NAME OF

UNITED STATES BUREAU OF LAND MANAGEMENT

APPLICATION NO. R-68503

PERMIT NO. R-III19

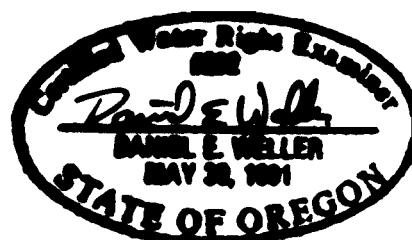

EXPIRES: JUNE 30, 2002

SURVEYED: AUGUST 29, 2000

THE PURPOSE OF THIS MAP IS FOR IDENTIFYING THE LOCATION OF THE WATER RIGHT ONLY AND
IS NOT INTENDED TO PROVIDE LEGAL DIMENSIONS OR LOCATION OF PROPERTY OWNERSHIP LINES.

BLM PROJECT NO. OR-10-5296,5429

U.S. BUREAU OF LAND MANAGEMENT-OSO
BRANCH OF CADASTRAL SURVEY
DWG: LANI

EXECUTED BY:
DANIEL E. WELLER, PLS, CWRE
P.O. BOX 2965
PORTLAND, OREGON 97208