

LOCATION
SEC. 14, T.2N., R.10E., W.M., HOOD RIVER COUNTY, OR.
RECEIVED

AUG 20 1999




CERTIFICATE:

I, ROY O. GAYLORD, THE WITHIN REGISTERED WATER RIGHT EXAMINER DO HEREBY CERTIFY THAT THIS MAP WAS PREPARED BY ME AND IS FOR THE PURPOSE OF IDENTIFYING THE LOCATION OF THE WATER RIGHT ONLY AND HAS NO INTENT TO PROVIDE DIMENSIONS OR LOCATION OF PROPERTY OWNERSHIP LINES.

WATER RESOURCES DEPT
SALEM, OREGON

DIVERSION POINT BY N.A.D. 1983. LATITUDE = NORTH 45° 39' 31", LONGITUDE = WEST 121° 32' 16";
OREGON NORTH ZONE, 727,961.66, EAST 7,936,759.27;
FROM THE WEST 1/4 CORNER NORTH 651.5', EAST 1,808.9'.


NORTHWEST QUARTER
OF SECTION 14

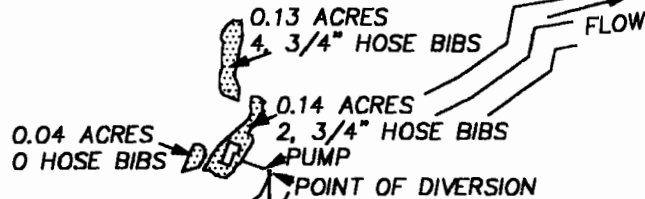

TOTAL ACRES OF IRRIGATION = 0.31

WEST 1/4 CORNER
OF SECTION 14

1808.90

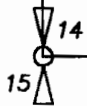

SCALE: 1"=400 FEET



**FINAL PROOF SURVEY
UNDER**

APPLICATION No. 71317 PERMIT No. 51761

IN THE NAME OF

WILLIAM ELLERY KIMBER C/O WILLIAM E. KIMBER, Jr.

SURVEYED JULY 20, 1999, BY ROY O. GAYLORD

DATE: AUGUST, 1999

SCALE: 1" = 400'

PROJECT: 9942WATER

P.O. BOX 617

HOOD RIVER, OREGON 97031

PHONE & FAX: (541) 386-4531

terra@gorge.net