


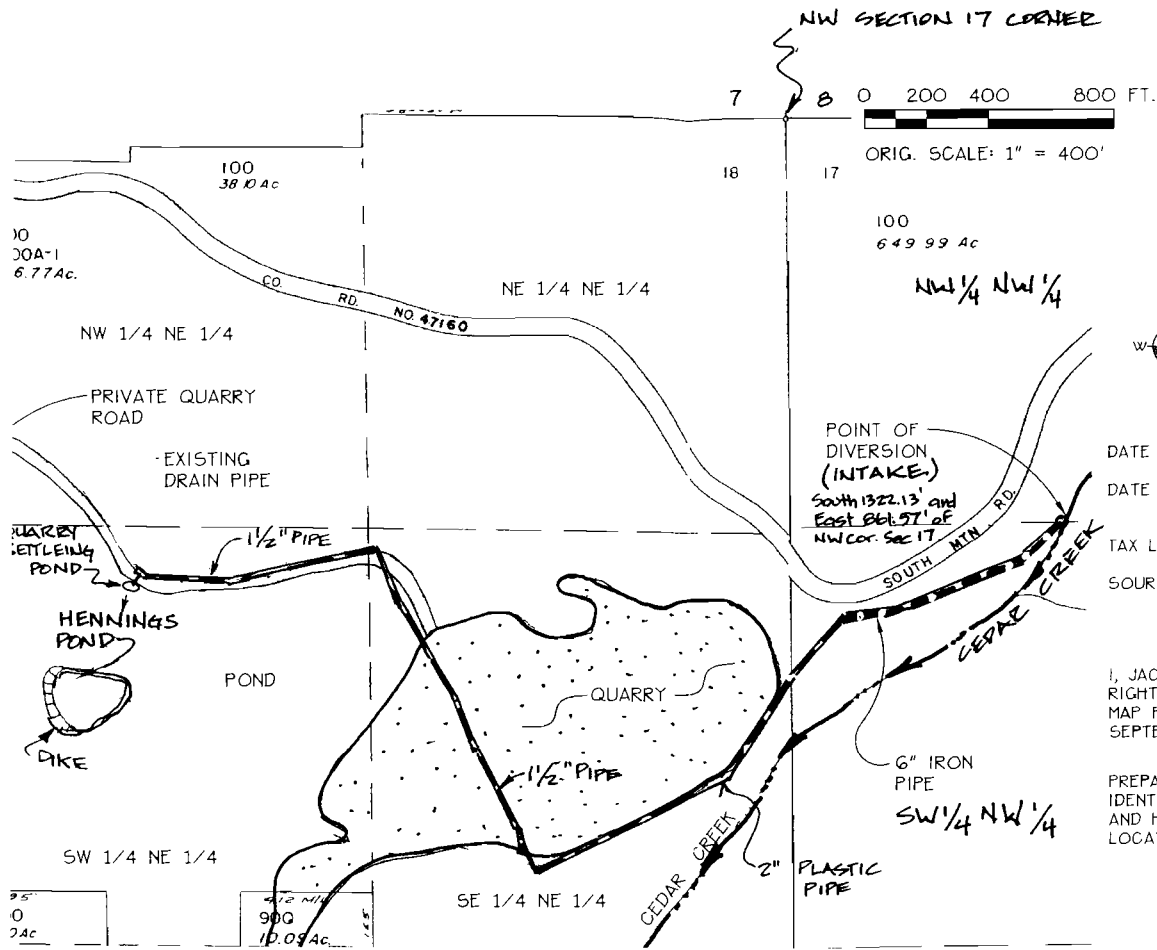

MAP OF BENEFICIAL USE
UNDER
PERMIT No. R-11532 + PERMIT No. 51593
IN NAME OF
GRACE HENNINGS TRUST
C/O BILL HENNINGS, CO-TRUSTEE
+ JUDY BUTLER, CO-TRUSTEE
1950 POPCORN ST. NW
SALEM, OR 97304
Located in
SECTIONS 17 and 18, T.14S.,
R.7W., W.M., BENTON CO., OREGON

DATE OF SITE INSPECTION: SEPTEMBER 23, 2003

DATE OF MAP: SEPTEMBER 30, 2003

TAX LOT: 200 (14-7W-18)

SOURCE: CEDAR CREEK, A TRIBUTARY OF SOUTH FORK ALSEA RIVER

1, JACK R. BURRELL, BEING DULY SWORN AS A WATER RIGHT EXAMINER, LICENSE No. 209, HAVE PREPARED THIS MAP FOR GRACE HENNINGS TRUST ON THIS 30th DAY OF SEPTEMBER 2003.

PREPARATION OF THIS MAP IS FOR THE PURPOSE OF IDENTIFYING THE LOCATION OF THE WATER RIGHT ONLY AND HAS NO INTENT TO PROVIDE DIMENSIONS OF LOCATION OF PROPERTY OWNERSHIP LINES.

Certified Water Right Examiner
#209 WRE
Jack R. Burrell
May 30, 1989